IREDELL COUNTY HEALTH DEPARTMENT

Statesville Phone TR 3-7271 — Mooresville Phone NO 3-1271

PERMIT TO INSTALL SEPTIC TANK

Permit NO. _____ Permit Date Sept 29 19 61

Owner Joe Dellinger Address Renfrow Rd.

Installed By C Hoke Address R 7


Location of Property 3rd on right over Renfrow Rd.

Tank	Capacity	Length of Lines	Fixtures
Block ( )	800 ( )	150' ( )	No. of Baths (1)
Precast (✓)	900 ( )	175' ( )	Dishwasher ( )
	1000 (✓)	200' ( )	Garbage Grdr. ( )
none	1100 ( )	225' (✓)	Auto-Washer ( )
	1200 ( )	250' ( )	Other _____
	Other _____	Other _____	

NOTIFY HEALTH DEPARTMENT AT LEAST EIGHT HOURS BEFORE TANK IS TO BE INSPECTED.

Final Inspection 9-29 19 61 Approved (✓) Disapproved ( )

Remarks Very narrow lot

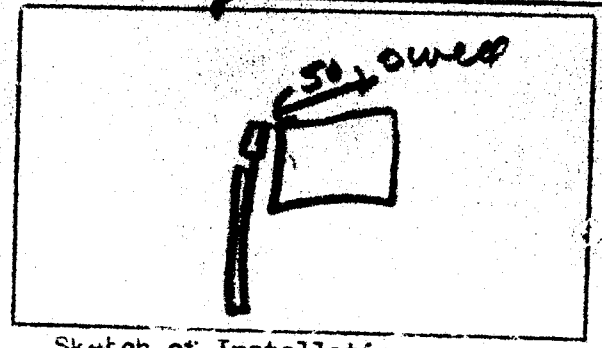

Sketch of Installation

R.A.L.

Sanitarian