IREDELL COUNTY HEALTH DEPARTMENT

STATESVILLE 704-878-5305 MOORESVILLE 704-664-5281

IMPROVEMENT PERMIT / AUTHORIZATION TO CONSTRUCT / OPERATION PERMIT / EXISTING SYSTEM INSPECTION

PERMIT # Repair PIN # 4724548727 DATE 7/22/09

OWNER or APPLICANT Peggy Summers PHONE: Business 704 500 8090 Home:

OWNER or APPLICANT ADDRESS 2812 Meadowbrook Rd.

LOCATION / DIRECTIONS Hwy 70W, turn (R) on Bristol, (L) on Meadowbrook, House on right.

SUBDIVISION n/a BLOCK / SECTION n/a LOT # Lot 2 LOT AREA DESIGN FLOW 240 L.T.A.R.

Septic Tank 1000 Gallons: STB 1460 Date 3-6-09

Pump Tank Gallons: P.T Date

Pump Make Model Serial #

Nitrification Field No Fields 1 No Lines 4 Linear Feet 200

Trench Width 36" Max. Trench Bottom Depth 36" Gravel Depth n/a

☒ New System ☐ Repair ☐ Expansion System Type I (II) III IV V VI

System Description:

Repair System Description: 25% Reduction

Maintenance Agreement Required ☐ YES ☒ NO

☒ GRAVITY ☐ PRESSURE

☒ Residence No. Bedrooms 2 ☐ Business No. Persons ☐ Other No. Employees ☐ Slab ☒ Crawl Space ☐ Basement w/plumbing ☐ Basement w/o plumbing

Water Supply: ☒ Private ☐ Public ☐ Community


Comments / Conditions

Existing tank to be abandoned due to distance from well
New tank and drainfield to be installed.
Relocate plumbing to opposite side of house

Comments / Conditions

Red Lush Fill

INITIAL SITE SKETCH

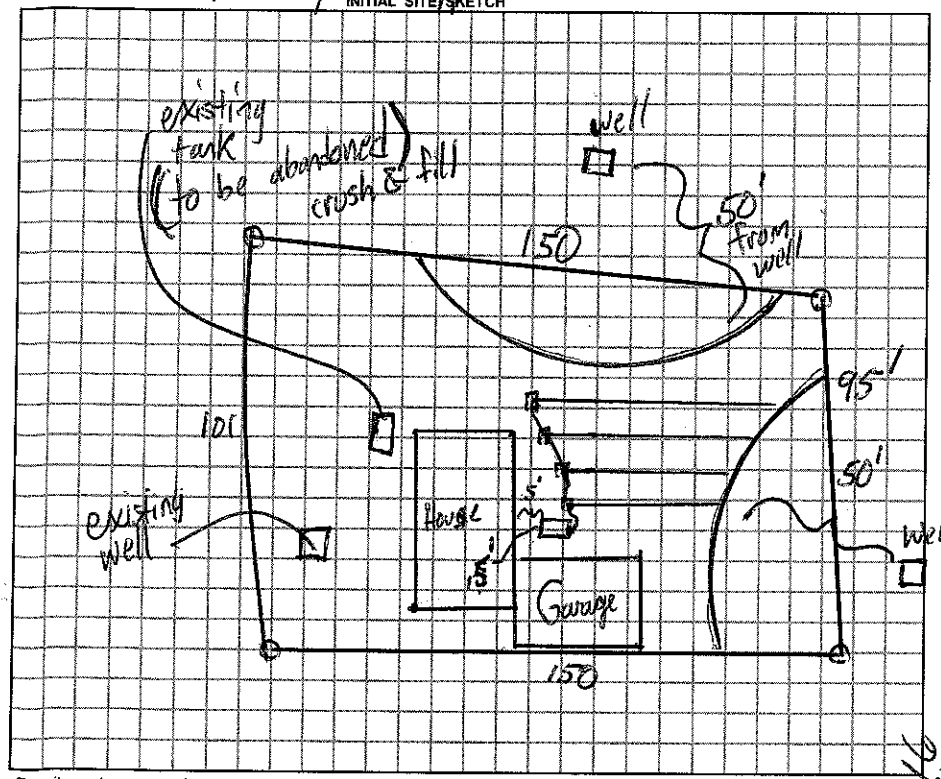

AS BUILT SKETCH

Septic Marker

Permit can be suspended or revoked if any false information is supplied toward securing the permit / any unauthorized changes are made to the site / any unauthorized changes are made in the installation of the system.

☐ *IMPROVEMENT PERMIT w / plat valid without expiration.* ☒ *IMPROVEMENT PERMIT w / site plan valid for 60 mos.* ☒ *AUTHORIZATION TO CONSTRUCT valid for period equal to IMPROVEMENT PERMIT-not to exceed 60 mo.*

Owner / Applicant Signature: James Ballew Date 7-23-09 Installed by: A-1 Backhoe

Improvement Permit by: Date 7-22-09 Operation Permit by: Date:

Authorization to Construct by: Date 7-22-09 Existing System Inspected by: Date:

YOU SHOULD CONTACT A LOCATOR SERVICE PRIOR TO ANY EXCAVATION.

WHITE COPY Environmental Health YELLOW COPY (Final) Owner / Applicant PINK COPY (Initial) Owner / Applicant