IREDELL COUNTY HEALTH DEPARTMENT

STATESVILLE 704-878-5305 MOORESVILLE 704-664-5281

IMPROVEMENT PERMIT / AUTHORIZATION TO CONSTRUCT / OPERATION PERMIT / EXISTING SYSTEM INSPECTION

PERMIT# Repair PIN# DATE 2-18-99

OWNER OR CONTRACTOR James Wyatt PHONE: Business Home 871-0230

ADDRESS 810 Bristol Drive Statesville

LOCATION Newton Drive TR Bristol Drive 3rd House on Left

SUBDIVISION BLOCK / SECTION LOT LOT AREA SITE CLASS. DESIGN FLOW 360 L.T.A.R.

Septic Tank: Existing Gallons: STB Date

Pump Tank: Gallons: PT Date

Pump Make: Model Serial No.

Nitrification Field: No Fields 1 Square Feet Linear Feet 230

No Lines 3 Trench Width 36in Max Trench Bottom Depth 36in Gravel Depth 12in

☐ New System ☐ Repair System Type: I. II. III. IV. V. VI

System Description:

Repair System Description: Gravity Conventional

Maintenance Agreement Required: Yes X No

☒ House/Mod. Home No. Bedrooms 3

☐ Mobile Home No. Bathrooms 1

☐ Business No. Employees

☐ Other


☐ Slab ☒ Crawl Space ☐ Basement w/plumbing ☐ Basement wo/plumbing

Water Supply: ☒ Individual ☐ Public ☐ Community


Comments/Conditions: Install 3 lines on contour 9ft on center, a run solid ghued pipe out 100ft to first dist Box Keep solid pipe 25ft from well 5ft from property line

Comments Conditions

INITIAL SITE SKETCH

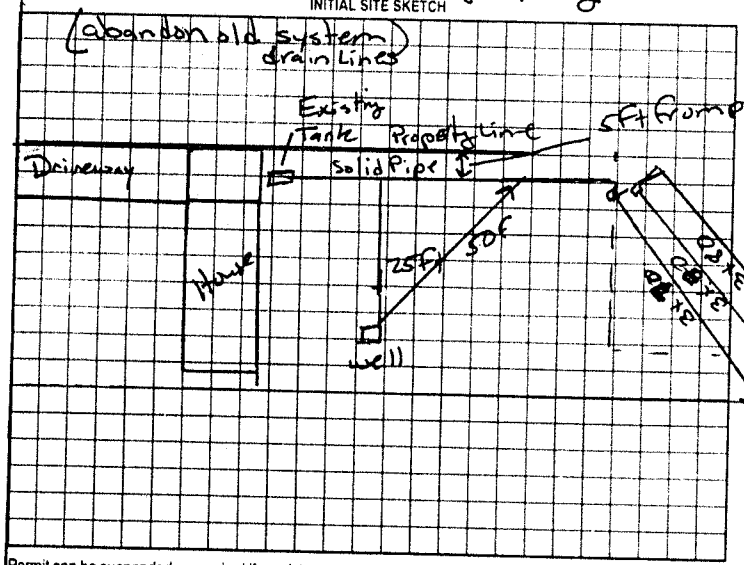

AS BUILT SKETCH

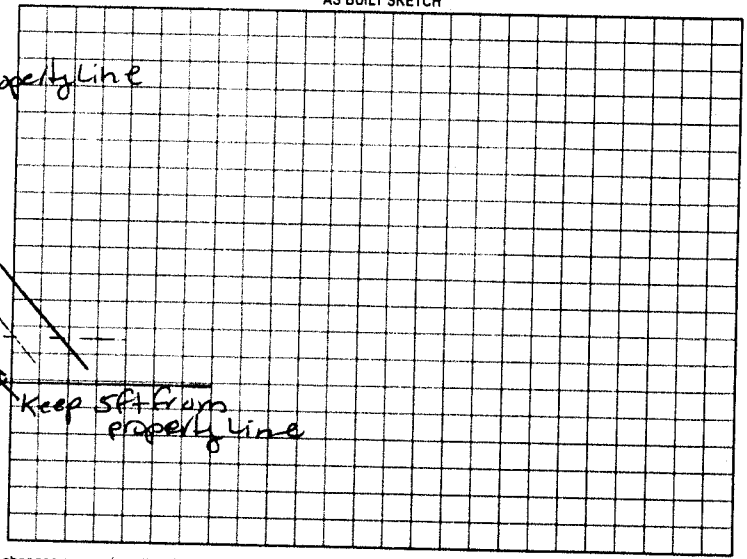

Permit can be suspended or revoked if any false information is supplied toward securing the permit/any unauthorized changes are made to the site/any unauthorized changes are made in the installation of the system. Improvement Permit with plat valid without expiration. Improvement Permit with site plan valid for sixty months. Authorization to Construct is valid for a period equal to that of Improvement Permit - not to exceed sixty months.

Signed: Mrs James Wyatt

Improvement Permit by: Mary Catt RS date 2-18-99

Authorization to Construct by: Mary Catt RS date 2-18-99

Installed by: Jerald Lackey

Operation Permit by: Mary Catt RS date 3-12-99

Existing System Inspection by: date

HEALTH DEPT COPY WHITE OWNER COPY (FINAL) YELLOW OWNER COPY (INITIAL) PINK