IREDELL COUNTY HEALTH DEPARTMENT

Statesville Phone TR 3-7271 Mooresville Phone NO 3-1271

PERMIT TO INSTALL SEPTIC TANK

Permit NO. _____ Permit Date Nov. 6, 1958

Owner G M. RUSTLE Address _____

Installed By SETZER Address _____


Location of Property ONT #21 TOWARD Hickory - RIGHT AT CARLINA INN - LEFT AT NEXT RIAD 1st HOUSE ON RIGHT

Tank		Capacity		Length of Lines		Fixtures	
Block	( )	800	(✓)	150'	(✓)	No. of Baths	( )
Precast	(✓)	900	( )	175'	( )	Dishwasher	( )
		1000	( )	200'	( )	Garbage Grdr.	( )
		1100	( )	225'	( )	Auto-Washer	( )
		1200	( )	250'	( )	Other	
		Other		Other			

NOTIFY HEALTH DEPARTMENT AT LEAST EIGHT HOURS BEFORE TANK IS TO BE INSPECTED.

Final Inspection NOV 6, 1958 Approved (✓) Disapproved ( )

Remarks _____

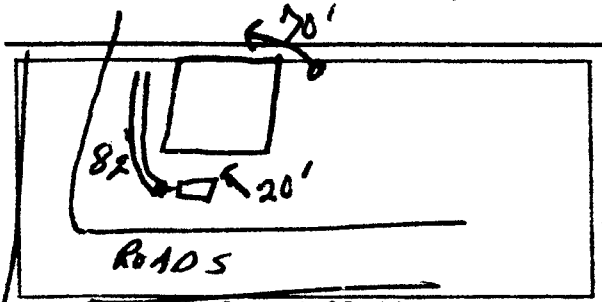

Sketch of Installation

Rafael A. Thomas

Sanitarian