IREDELL COUNTY HEALTH DEPARTMENT

STATESVILLE 704-878-5305 MOORESVILLE 704-664-5281

IMPROVEMENT PERMIT / AUTHORIZATION TO CONSTRUCT / OPERATION PERMIT / EXISTING SYSTEM INSPECTION

PERMIT# Repair PIN# DATE 4-29-99

OWNER OR CONTRACTOR Howard Sharpe PHONE: Business Home 873-2421

ADDRESS 606 Bellemeade Ave Statesville

LOCATION 70W TR Bristol TR Meadowview TR Bellemeade House on (L) near end.

SUBDIVISION BLOCK / SECTION LOT LOT AREA SITE CLASS P/S DESIGN FLOW 360 L.T.A.R. Existing

Septic Tank: 1000 Ex. Gallons; STB Date

Pump Tank: Gallons; PT Date

Pump Make: Model Serial No.

Nitrification Field: No Fields 1 Square Feet Linear Feet 180ft

No Lines 2 Trench Width 36in Max Trench Bottom Depth 36in Gravel Depth 12inf

☐ New System ☒ Repair System Type: I (II) III, IV, V, VI

System Description:

Repair System Description: Gravity Convention

Maintenance Agreement Required: ☐ Yes ☐ No

☒ House/Mod. Home No. Bedrooms 3

☐ Mobile Home No. Bathrooms 1

☐ Business No. Employees

☐ Other


☐ Slab ☒ Crawl Space ☐ Basement w/plumbing ☐ Basement wo/plumbing

Water Supply: ☒ Individual ☐ Public ☐ Community


Comments/Conditions: This permit serves as Notice of Violation Feed Directly from Tank use 1 Drop Box Split feed lines, Check sanitary T' replace if needed.

Comments/Conditions

INITIAL SITE SKETCH

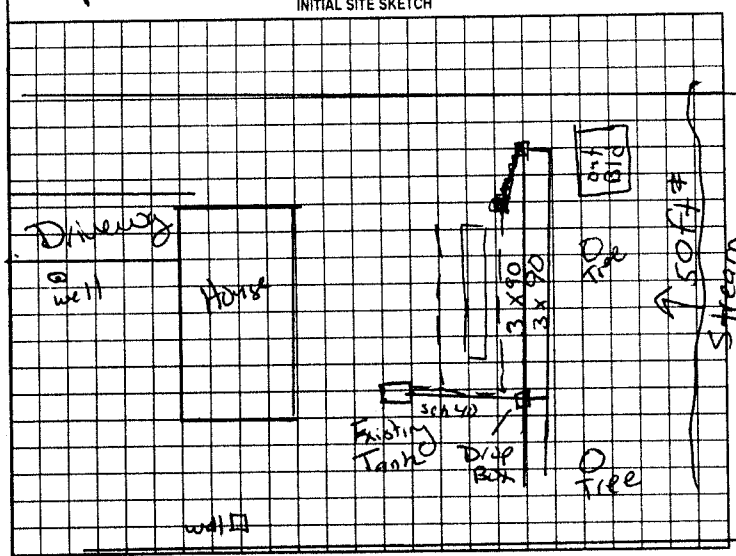

AS BUILT SKETCH

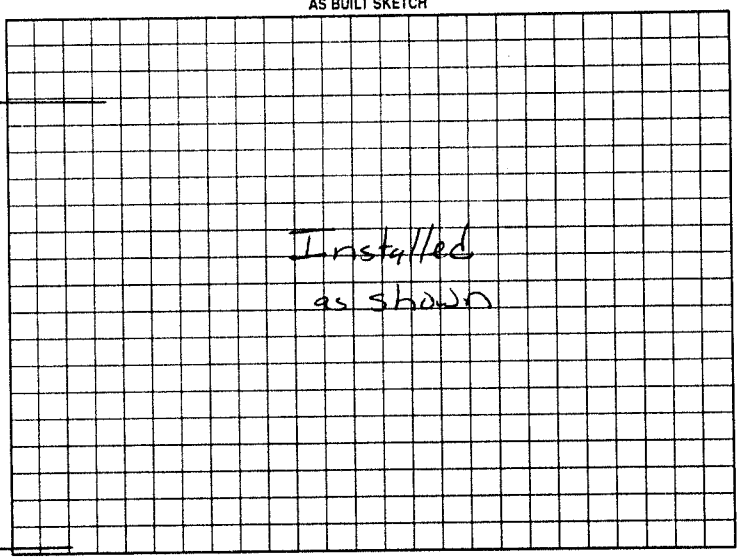

Permit can be suspended or revoked if any false information is supplied toward securing the permit/any unauthorized changes are made to the site/any unauthorized changes are made in the installation of the system. Improvement Permit with plat valid without expiration. Improvement Permit with site plan valid for sixty months. Authorization to Construct is valid for a period equal to that of Improvement Permit – not to exceed sixty months.

Signed: Howard Sharpe date 4-29-99

Improvement Permit by: Mark Cox RS date 4-29-99

Authorization to Construct by: Mark Cox RS date 4-29-99

Installed by: Wes Lytton

Operation Permit by: Mark Cox RS date 6-29-99

Existing System Inspection by: date

HEALTH DEPT COPY: WHITE OWNER COPY (FINAL) YELLOW OWNER COPY (INITIAL) PINK