IREDELL COUNTY HEALTH DEPARTMENT

Statesville Phone TR 3-7271 Mooresville Phone NO 3-1271

PERMIT TO INSTALL SEPTIC TANK

Permit NO. _____ Permit Date JULY 25 1958

Owner PAUL BARNES Address STATESVILLE

Installed By OSTWALT Address _____


Location of Property ONT # 70 WEST - RIGHT AT CAROLINA INN - LEFT AT FIRST DIRT RD - RIGHT AT DEAD IN - LAST HOUSE

Tank		Capacity		Length of Lines		Fixtures	
Block	(✓)	800	( )	150'	(✓)	No. of Baths	(1)
Precast	( )	900	(✓)	175'	( )	Dishwasher	( )
		1000	( )	200'	( )	Garbage Grdr.	( )
		1100	( )	225'	( )	Auto-Washer	( )
		1200	( )	250'	( )	Other	_____
		Other	_____	Other	_____		

NOTIFY HEALTH DEPARTMENT AT LEAST EIGHT HOURS BEFORE TANK IS TO BE INSPECTED.

Final Inspection JULY 25 1958 Approved (✓) Disapproved ( )

Remarks _____

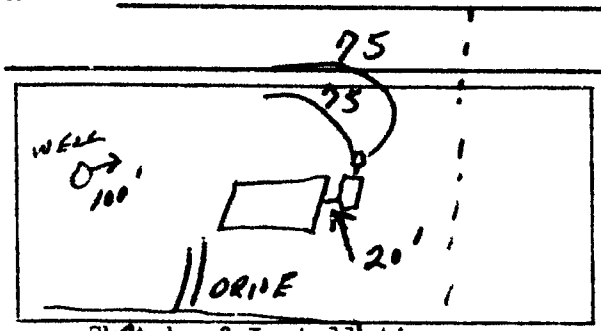

Sketch of Installation

Rufford G. Thomas

Sanitarian