IREDELL COUNTY HEALTH DEPARTMENT

Statesville Phone TR 3-7271 Mooresville Phone NO 3-1271

PERMIT TO INSTALL SEPTIC TANK

Permit NO. _____ Permit Date MAY 16, 1959

Owner J.S. CLOER (PAUL BARNES BUILDER) Address _____

Installed By HOME Address _____


Location of Property SUB-DIVISION BEHIND CAROLINA INN LAST ROAD TO RIGHT NEXT TO LAST HOUSE ON RIGHT BRICK

Tank		Capacity		Length of Lines		Fixtures	
Block	( )	800	(✓)	150'	(✓)	No. of Baths	(1)
Precast	(✓)	900	( )	175'	( )	Dishwasher	( )
		1000	( )	200'	( )	Garbage Grdr.	( )
		1100	( )	225'	( )	Auto-Washer	( )
		1200	( )	250'	( )	Other	_____
		Other	_____	Other	_____		

NOTIFY HEALTH DEPARTMENT AT LEAST EIGHT HOURS BEFORE TANK IS TO BE INSPECTED.

Final Inspection MAY 16, 1959 Approved (✓) Disapproved ( )

Remarks NOT DESIGNED FOR AUTO-WASHER

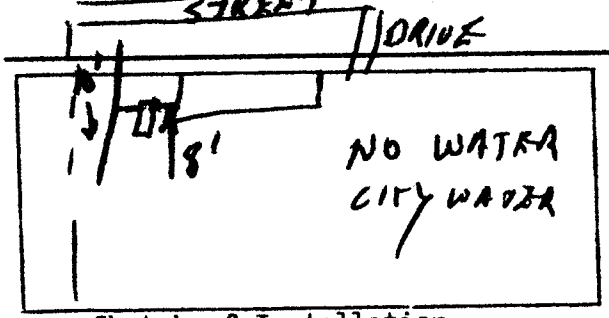

Sketch of Installation

Raford A. Thomas

Sanitarian