IREDELL COUNTY HEALTH DEPARTMENT

Statesville Phone TR 3-7271 Mooresville Phone MO 3-1271

PERMIT TO INSTALL SEPTIC TANK

Permit NO. _____ Permit Date May 16 1959

Owner Cloer - Paul Barnes Address Bristol Park

Installed By C Hooks Address R 7


Location of Property Bristol Park. North to last Ln on rt on last st

Tank		Capacity		Length of Lines		Fixtures	
Block	( )	800	(1)	150'	(1)	No. of Baths	(1)
Precast	(1)	900	( )	175'	( )	Dishwasher	( )
		1000	( )	200'	( )	Garbage Grdr.	( )
		1100	( )	225'	( )	Auto-Washer	( )
		1200	( )	250'	( )	Other	
		Other		Other			

NOTIFY HEALTH DEPARTMENT AT LEAST EIGHT HOURS BEFORE TANK IS TO BE INSPECTED.

Final Inspection May 16 1959 Approved ( ) Disapproved ( )

Remarks Not Copy for Wash. Checked by Thomas #2

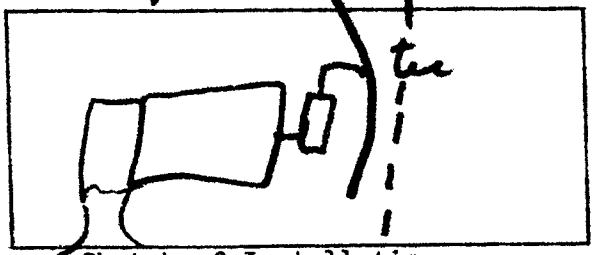

Sketch of Installation

RG 2

Sanitarian