IREDELL COUNTY HEALTH DEPARTMENT

Statesville Office (704) 878-5305 Mooresville Office (704) 660-3625 PERMIT # 22242

IMPROVEMENT PERMIT / AUTHORIZATION TO CONSTRUCT / OPERATION PERMIT / EXISTING SYSTEM

PIN # 4724553243

APPLICANT: Main Street Homes APPLICANT ADDRESS: 2908 Eastway Drive Statesville 28625

SITE ADDRESS: 607 Belle Meade Ave Statesville NC 28677 PHONE: 704-873-0544 ALT. PHONE: 704-318-6111

SITE DIRECTIONS: W. Front St to Bristol Drive, RT onto Meadow Brook Rd, RT onto Belle Meade Ave, House on RT @ end of Street


SUBDIVISION: N/A SECTION: N/A LOT # N/A LOT AREA: — DESIGN FLOW: Ex L.T.A.R.: Ex

Septic Tank Ex (gal)	STB	Date	☐ New System ☐ Repair ☐ Expansion	System Type: I II III IV V VI	☒ Residence	No. Bedrooms 2	Water Supply
Pump Tank (gal)	PT	Date	System Description: Existing System (House addition)		☐ Business	No. Persons	☒ Private
Pump Make	Model	Serial #	Repair System Description:		☐ Other	No. Employees	☐ Public
# Nitrification Fields Ex	# Lines Ex	Linear Ft: Ex	Maintenance Agreement Required:	☐ YES ☒ NO	☐ Slab	☐ Crawl Space	☐ Community
Trench Width Ex	Max. Trench Bottom Depth Ex	Gravel Depth Ex	☒ GRAVITY	☐ PRESSURE	☐ Basement w/plumbing		☐ Basement w/o plumbing

Comments / Conditions:

INITIAL SITE SKETCH

AS BUILT SKETCH

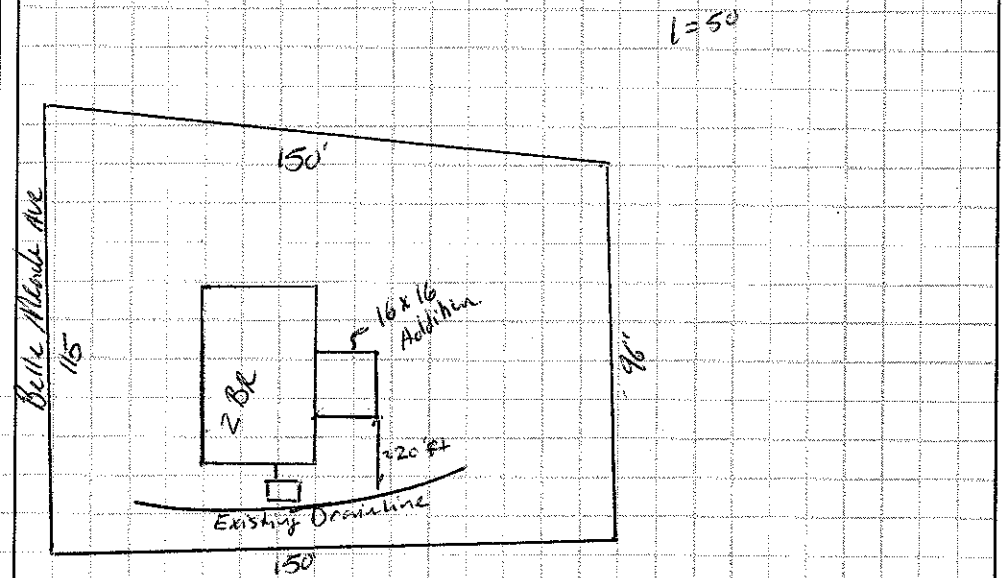

Permit can be suspended or revoked if any false information is supplied toward securing the permit / any unauthorized changes are made to the site / any unauthorized changes are made in the installation of the system. **CONTACT A LOCATOR SERVICE PRIOR TO ANY EXCAVATION**

☐ **IMPROVEMENT PERMIT** *with plat* valid without expiration. ☐ **IMPROVEMENT PERMIT** *with site plan* valid for 60 mos. ☐ **AUTHORIZATION TO CONSTRUCT** valid for period equal to IMPROVEMENT PERMIT--not to exceed 60 mo.

Owner / Applicant Signature: Doris Cleer Date: 12-6-16 Installed by:

IMPROVEMENT PERMIT by: Date: OPERATION PERMIT by: Date:

AUTHORIZATION TO CONSTRUCT by: Date: Existing System Inspected by: Date: 12/02/16

Health Dept. Copy - WHITE Applicant (Final Approval) - YELLOW Applicant (Conditional Approval) - PINK