IREDELL COUNTY HEALTH DEPARTMENT

STATESVILLE 704-878-5305 MOORESVILLE 704-664-5281

IMPROVEMENT PERMIT / AUTHORIZATION TO CONSTRUCT / OPERATION PERMIT / EXISTING SYSTEM INSPECTION

PERMIT# Repair PIN# DATE 3-4-99

OWNER OR CONTRACTOR Sherman Wallace PHONE: Business Home 872-6405

ADDRESS 608 Glenview Drive Statesville

LOCATION Bristol Drive TR Meadowview TR Glenview TR (sign says Greenfield)

SUBDIVISION BLOCK / SECTION LOT LOT AREA SITE CLASS 5/5 DESIGN FLOW 240 L.T.A.R. Existing

Septic Tank: Existing Gallons; STB Date

Pump Tank: Gallons; PT Date

Pump Make: Model Serial No.

Nitrification Field: No Fields 1 Square Feet 540 Linear Feet 180

No Lines 3 Trench Width 36 Max Trench Bottom Depth 36

☐ New System ☒ Repair System Type: I (II) III. IV. V. VI

System Description:

Repair System Description: Gravity Conventional

Maintenance Agreement Required ☐ Yes ☒ No

Gravel Depth 18

☒ House/Mod. Home No. Bedrooms 2

☐ Mobile Home No. Bathrooms

☐ Business No. Employees

☐ Other


☐ Slab ☐ Crawl Space ☐ Basement w/plumbing ☐ Basement wo/plumbing

Water Supply: ☒ Individual ☐ Public ☐ Community underground

Comments/Conditions: Install 3 lines on contour, 9ft on center. ~~Need to [illegible] tie washer line into tank.~~ (Not washer line) Need to run gutter lines off system / solid pipe - Pool Deck Drain Needs to be re located.

Comments/Conditions

INITIAL SITE SKETCH

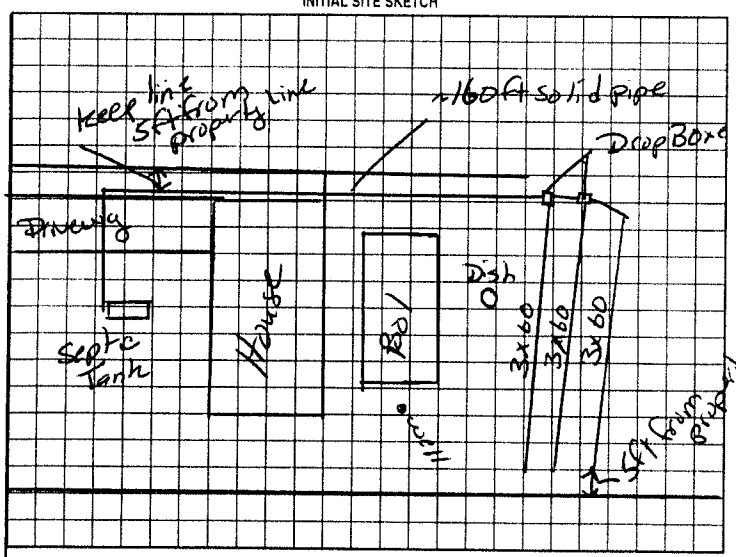

AS BUILT SKETCH

Permit can be suspended or revoked if any false information is supplied toward securing the permit/any unauthorized changes are made to the site/any unauthorized changes are made in the installation of the system. Improvement Permit with plat valid without expiration. Improvement Permit with site plan valid for sixty months. Authorization to Construct is valid for a period equal to that of Improvement Permit – not to exceed sixty months.

Signed: Betty H. Wallace date

Improvement Permit by: MH C Off RS date 3-4-99

Authorization to Construct by: MH C Off RS date 3-4-99

Installed by: Andy Daniels

Operation Permit by: MH C Off RS date 3-26-99

Existing System Inspection by: date

HEALTH DEPT COPY WHITE OWNER COPY (FINAL) YELLOW OWNER COPY (INITIAL) PINK