IREDELL COUNTY HEALTH DEPARTMENT

Statesville Office (704) 878-5305 Mooresville Office (704) 660-3625 PERMIT # 200863 SF

IMPROVEMENT PERMIT / AUTHORIZATION TO CONSTRUCT / OPERATION PERMIT / EXISTING SYSTEM

PIN # 4724589798

APPLICANT: Gary Helton APPLICANT ADDRESS: 218 C Street

SITE ADDRESS: 218 C Street PHONE: 704-657-6444 ALT. PHONE: N/A

SITE DIRECTIONS: Bristol Rd TR Westminster Dr TR C Street Property on Left

SUBDIVISION: J W Sherrill SECTION: N/A LOT # 159-161 LOT AREA: .27acres DESIGN FLOW: 240gpd L.T.A.R.: 0.03


Septic Tank	Existing (gal)	STB	Date	☐ New System	☑ Repair	☐ Expansion	System Type: I II ☑ III IV V VI	☑ Residence	No. Bedrooms 2
Pump Tank	(gal)	PT	Date	System Description:				☐ Business	No. Persons 4
Pump Make	Model		Serial #	Repair System Description: 25% Reduction				☐ Other	No. Employees
# Nitrification Fields 1	# Lines 4		Linear Ft: 192	Maintenance Agreement Required:	☐ YES	☑ NO		☐ Slab	☑ Crawl Space
Trench Width 36"	Max. Trench Bottom Depth 36"		Gravel Depth N/A	☑ GRAVITY	☐ PRESSURE			☐ Basement w/plumbing	☐ Basement w/o plumbing

Water Supply: ☐ Private ☑ Public ☐ Community

Comments / Conditions: Install a 25% Reduction system on contour with serial distribution. Replace septic tank if needed. It is recommended that maple trees are removed from septic area.

- Install new drainlines with a minimum space of 8' on centers.

INITIAL SITE SKETCH

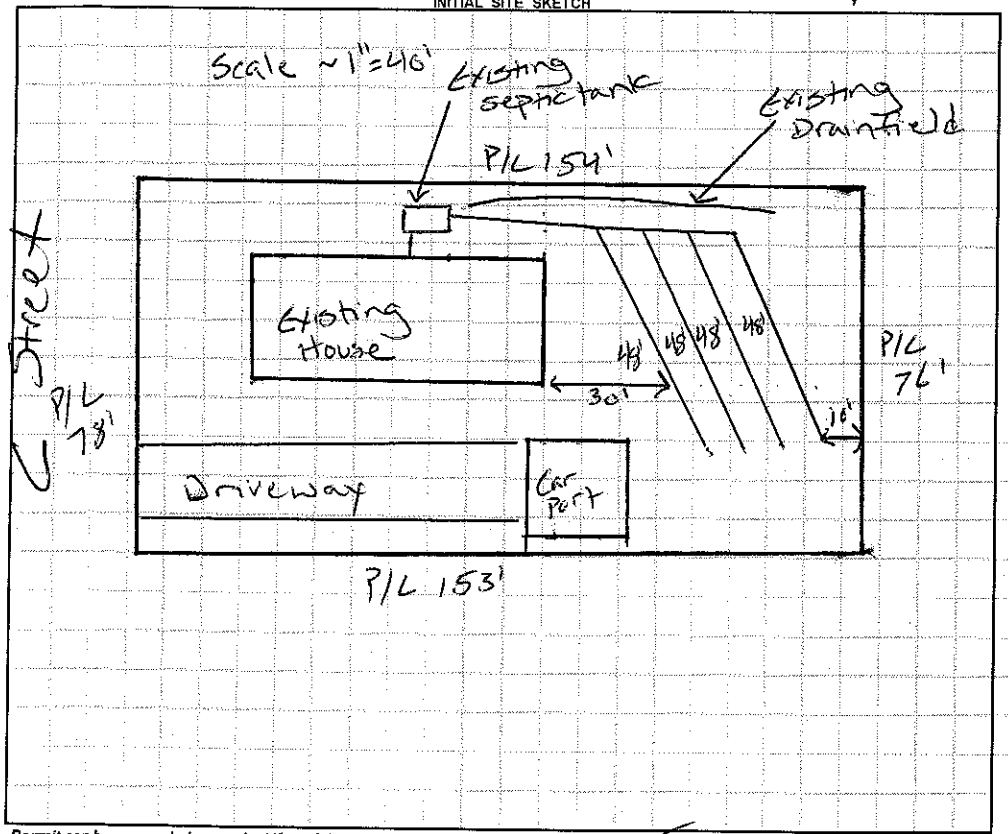

AS BUILT SKETCH

- Red Polylok Filter installed
- Quick 4 Chamber installed
- Installed as drawn

Permit can be suspended or revoked if any false information is supplied toward securing the permit / any unauthorized changes are made to the site / any unauthorized changes are made in the installation of the system. **CONTACT A LOCATOR SERVICE PRIOR TO ANY EXCAVATION**

☐ **IMPROVEMENT PERMIT** *with plat valid without expiration.* ☑ **IMPROVEMENT PERMIT** *with site plan valid for 60 mos.* ☑ **AUTHORIZATION TO CONSTRUCT** *valid for period equal to IMPROVEMENT PERMIT--not to exceed 60 mo.*

Owner / Applicant Signature: Gary A. Helton Date: 1/9/14 Installed by: K + M Grading

IMPROVEMENT PERMIT by: Justin Henderson Date: 1-8-14 OPERATION PERMIT by: Justin Henderson Date: 1-23-14

AUTHORIZATION TO CONSTRUCT by: Justin Henderson Date: 1-8-14 Existing System Inspected by: Date:

Health Dept. Copy - WHITE Applicant (Final Approval) - YELLOW Applicant (Conditional Approval) - PINK