IREDELL COUNTY HEALTH DEPARTMENT

Statesville Phone TR 3-7271 Mooresville Phone No. 664-5281

PERMIT TO INSTALL SEPTIC TANK

Permit No. _____ Permit Date 7-12 1973

Owner LANG WOODFIN Address 207-B STREET

Installed By YORK RUFTY Address Stony Point, N.C.


Location of Property 207 B. STREET

Tank		Capacity		Length of Lines		Fixtures	
Block	( )	1000	( )	225'	(✓)	No. of Baths	(✓)
Precast OLD TANK		1250	( )	250'	( )	Dishwasher	( )
		1500	( )	Other_____		Garbage Grdr.	( )
		Other_____				Other_____	

NOTIFY HEALTH DEPARTMENT AT LEAST EIGHT HOURS BEFORE TANK IS TO BE INSPECTED.

Final Inspection 7-12 1973 Approved (✓) Disapproved ( )

Remarks _____

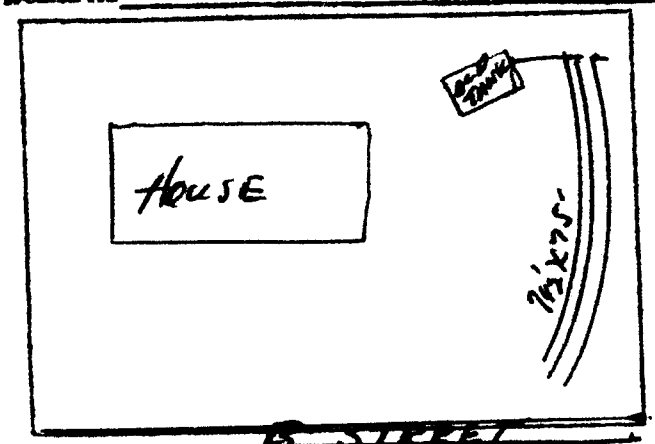

Sketch of Installation

Glenn Fox Jr.

Sanitarian