IREDELL COUNTY HEALTH DEPARTMENT

STATESVILLE 704-878-5305 MOORESVILLE 704-664-5281

IMPROVEMENT PERMIT / AUTHORIZATION TO CONSTRUCT / OPERATION PERMIT / EXISTING SYSTEM INSPECTION

PERMIT# Repair PIN#

OWNER OR CONTRACTOR Margaret + Allen Austin PHONE: Business Home DATE 3-17-98

ADDRESS 833 Bristol Drive Statesville

LOCATION 70W TR Bristol 2nd or 3rd house on (R)

SUBDIVISION BLOCK / SECTION LOT LOT AREA SITE CLASS. P/S DESIGN FLOW 240 L.T.A.R.

Septic Tank: 1000 Gallons; STB Date

Pump Tank: Gallons; PT Date

Pump Make: Model Serial No.

Nitrification Field: No Fields 1 Square Feet Linear Feet 200

No Lines 4 Trench Width 36 Max Trench Bottom Depth 36 Gravel Depth 18+ in

☐ New System ☒ Repair System Type: I, II, III, IV, V, VI

System Description:

Repair System Description: Gravity Conventional

Maintenance Agreement Required: ☐ Yes ☒ No

☒ House/Mod. Home No. Bedrooms 2

☐ Mobile Home No. Bathrooms 1

☐ Business No. Employees

☐ Other


☐ Slab ☒ Crawl Space ☐ Basement w/plumbing ☐ Basement wo/plumbing

Water Supply: ☒ Individual ☐ Public ☐ Community


Comments:/Conditions: (1) Must tie washer line back into system (2) Must Redirect gutter drains to keep water off system (3) Can walk Between fruit Trees (4) Keep 50 Ft from well

Comments:/Conditions:

INITIAL SITE SKETCH

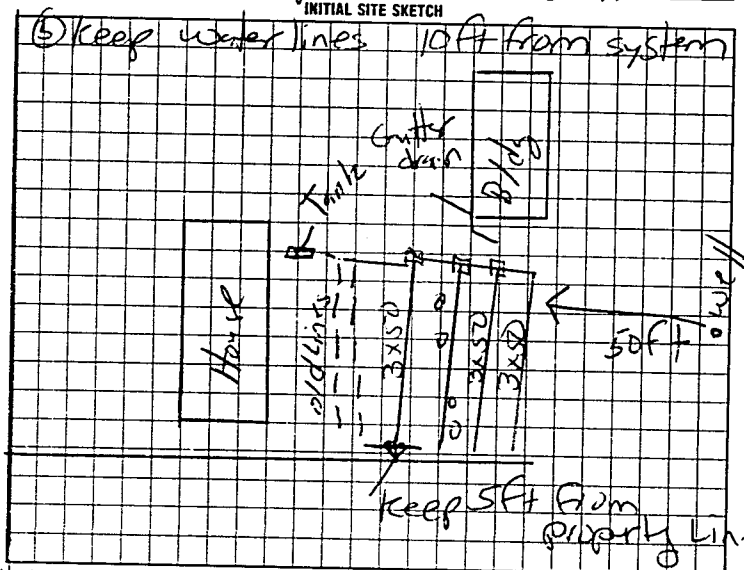

AS BUILT SKETCH

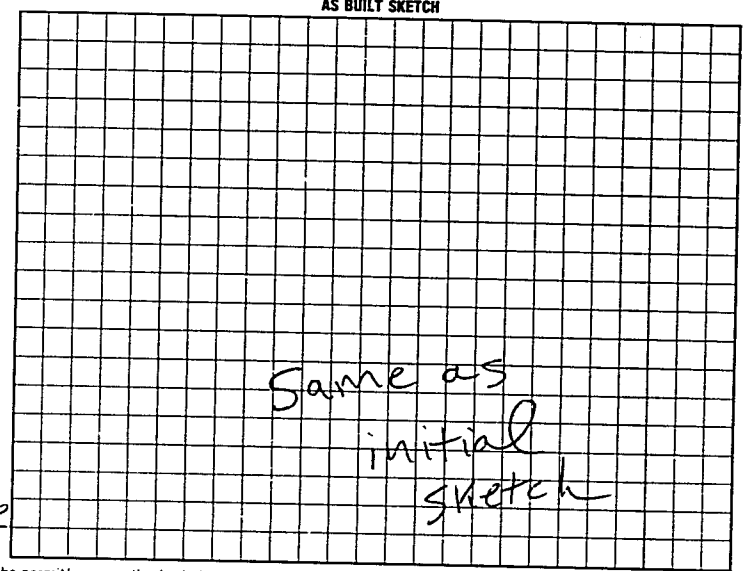

I understand that this permit can be suspended or revoked if any false information is supplied toward securing the permit/any unauthorized changes are made to the site/any unauthorized changes are made in the installation of the system. Improvement Permit with plat valid without expiration. Improvement Permit with site plan valid for sixty months. Authorization to Construct is valid for a period equal to that of Improvement Permit – not to exceed sixty months.

Signed: Danny Lanier

Improvement Permit by: Mat C. Oakes date 3-17-98

Authorization to Construct by: Mat C. Oakes date 3-17-98

Installed by: Barry Simmon

Operation Permit by: J. E. Moore date 10-6-98

Existing System Inspection by: date

HEALTH DEPT COPY (WHITE) INSPECTION COPY (PINK) OWNER COPY (PINK) YELLOW