IREDELL COUNTY HEALTH DEPARTMENT

STATESVILLE 704-878-5305 MOORESVILLE 704-664-5281

IMPROVEMENT PERMIT / AUTHORIZATION TO CONSTRUCT / OPERATION PERMIT / EXISTING SYSTEM INSPECTION

PERMIT # REPAIR PIN # 4724635954 DATE 8-21-09

OWNER or APPLICANT BOB Stiles PHONE: Business Home:

OWNER or APPLICANT ADDRESS 8210 BAKER ST Statesville NC 28625

LOCATION / DIRECTIONS Hwy 90 ⓛ Bristol ⓛ Baker on RT

SUBDIVISION BOLICK BLOCK / SECTION LOT # 20-22 LOT AREA 75'x157 DESIGN FLOW 240' L.T.A.R. .3

Septic Tank EXISTING Gallons: STB Date

Pump Tank Gallons: P T Date

Pump Make Model Serial #

Nitrification Field No Fields 1 No Lines 3 Linear Feet 180'

Trench Width 36" Max. Trench Bottom Depth 36" Gravel Depth N/A ☒ GRAVITY ☐ PRESSURE

☐ New System ☒ Repair ☐ Expansion System Type I II III IV V VI

System Description:

Repair System Description: Gravity 25'/. 18" SAND

Maintenance Agreement Required ☐ YES ☐ NO

☒ Residence No. Bedrooms 2

☐ Business No. Persons 1

☐ Other No. Employees

☐ Slab ☒ Crawl Space

☐ Basement w/plumbing ☐ Basement w/o plumbing

Water Supply: ☒ Private ☐ Public ☐ Community

Comments / Conditions ① Install 18" SAND BELOW 25'/. REDUCT System ② Use distribution box with speed levelers. ③ Check and install aerator and tank if necessary ④ Property lines need to be marked BY installation and

INITIAL SITE SKETCH

SEE ATTACHED

Comments / Conditions final to determine setbacks. #(5) Owner said lot was deeded BY 1977 SO 5' From P/L AS drawn TAX CARD ALSO said 1959. ⑥ Keep system deep enough to not bleed out in driveway cut.

AS BUILT SKETCH

THIS PERMIT SERVES AS NOTICE OF VIOLATION AND MUST BE Repaired in 30 DAYS.

* DUE TO GAS LINE INSTALLED 4 LINES 37' LONG. OWNER IS AWARE + EXTRA SAND added T-WOOD intank

Permit can be suspended or revoked if any false information is supplied toward securing the permit / any unauthorized changes are made to the site / any unauthorized changes are made in the installation of the system.

☐ *IMPROVEMENT PERMIT w / plat valid without expiration* ☐ *IMPROVEMENT PERMIT w / site plan valid for 60 mos.* ☒ *AUTHORIZATION TO CONSTRUCT valid for period equal to IMPROVEMENT PERMIT-not to exceed 60 mo.*

Owner / Applicant Signature: Date 8-24-09

Improvement Permit by: Date 8-21-09

Authorization to Construct by: Date 8-21-09

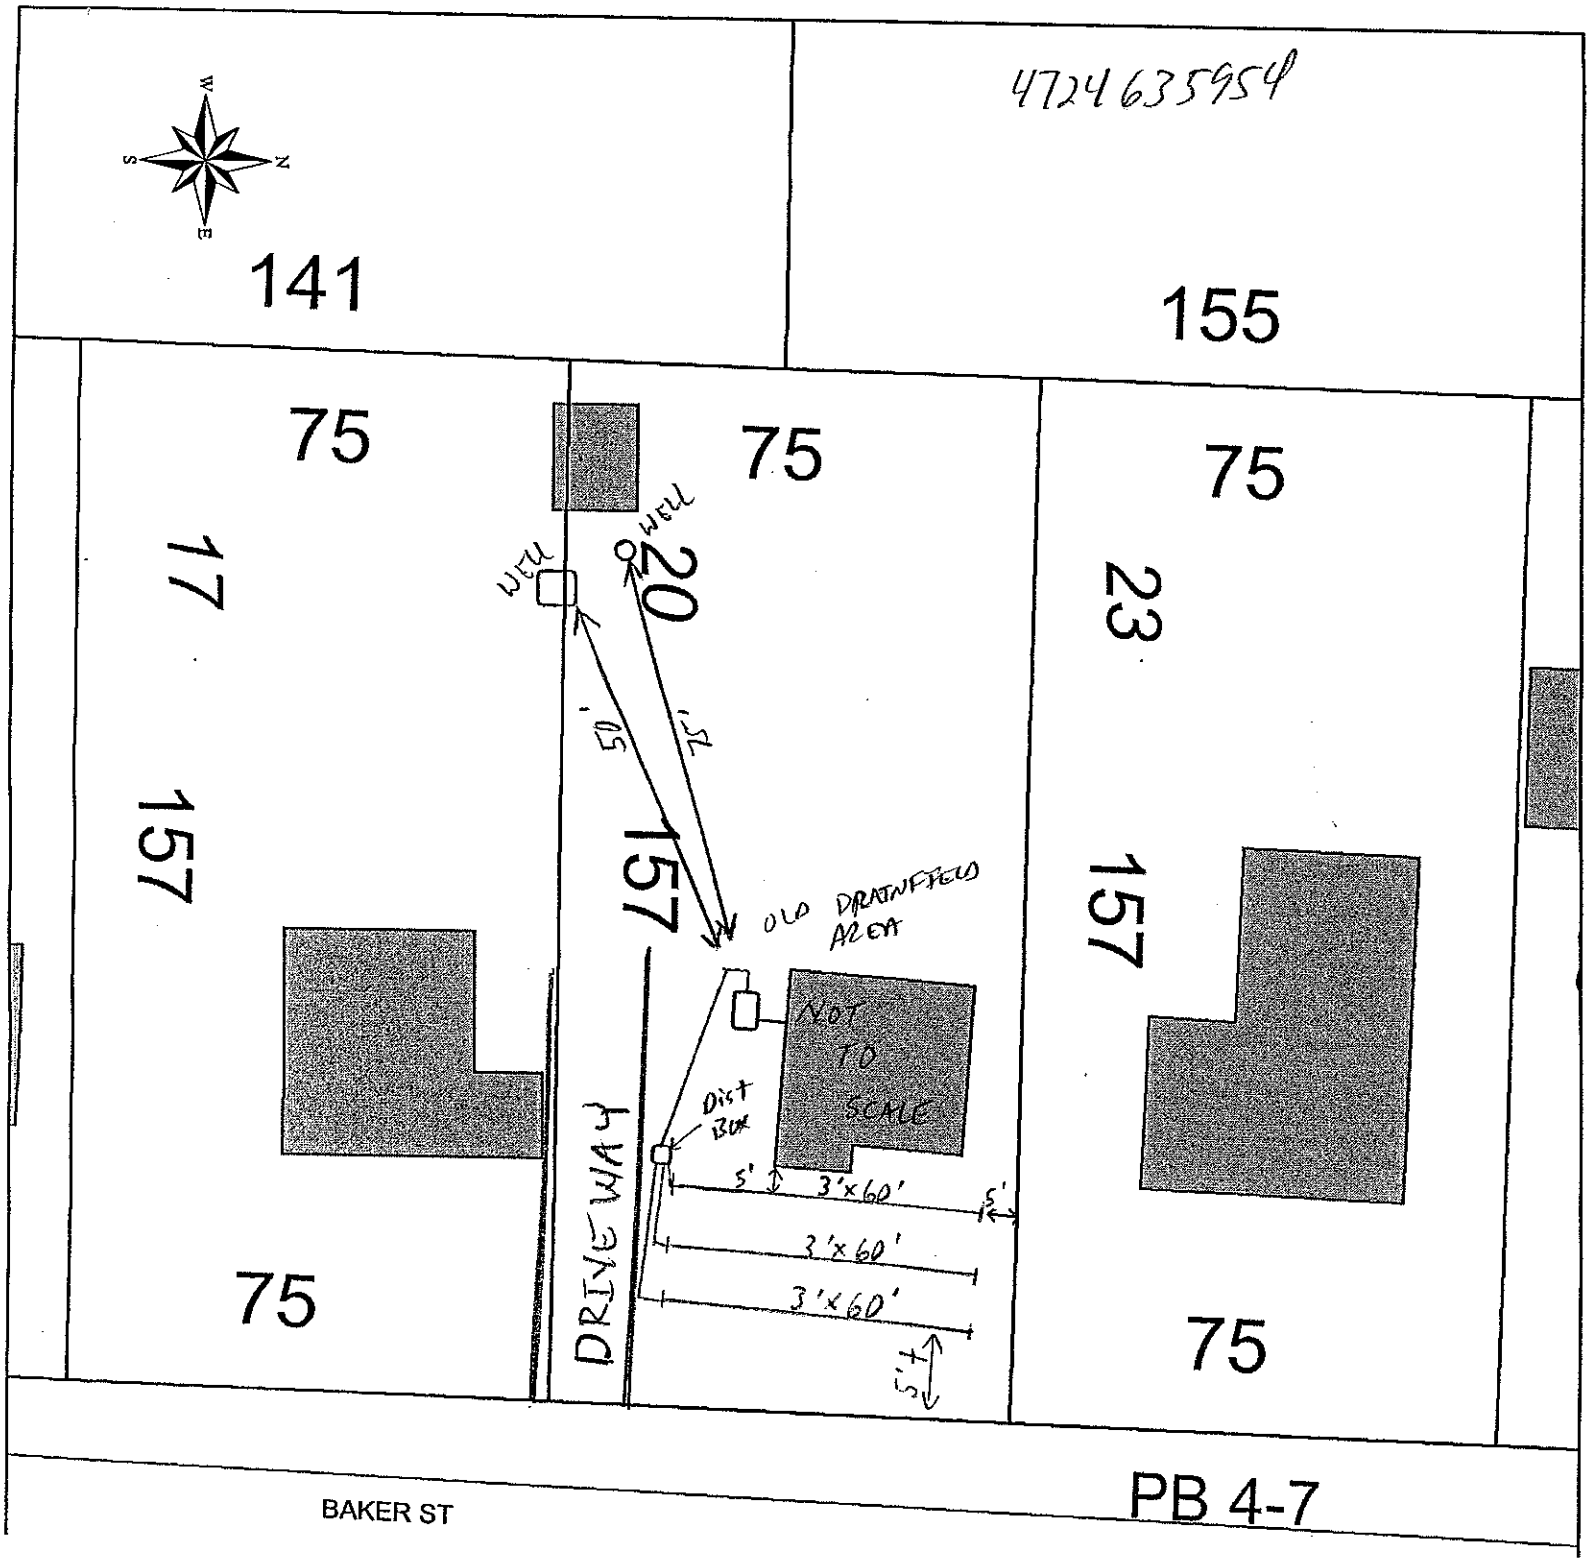
Installed by: A-1 BACKHOE

Operation Permit by: Date: 9-3-09

Existing System Inspected by: Date:

YOU SHOULD CONTACT A LOCATOR SERVICE PRIOR TO ANY EXCAVATION.

WHITE COPY Environmental Health YELLOW COPY (Final) Owner / Applicant PINK COPY (Initial) Owner / Applicant


4724635954
141
155
75
75
75
75
17
20
23
157
157
157
WELL
WELL
50'
75'
OLD DRAINFIELD AREA
NOT TO SCALE
DIST BOX
DRIVEWAY
5'
3'x60'
5'
3'x60'
3'x60'
5'
75
75
BAKER ST
PB 4-7