IREDELL COUNTY HEALTH DEPARTMENT

STATESVILLE 704-878-5305 MOORESVILLE 704-664-5281

IMPROVEMENT PERMIT / AUTHORIZATION TO CONSTRUCT / OPERATION PERMIT / EXISTING SYSTEM INSPECTION

PERMIT# 148946 PIN# 4724-64-3021 DATE 31 MARCH 08

OWNER OR APPLICANT Todd + Cynthia Rhyne PHONE: Business (704) 902-0383 Home

ADDRESS 816 whites Farm Rd. Statesville, N.C.

LOCATION 819 Bristol Drive Statesville, N.C.

SUBDIVISION BLOCK / SECTION LOT LOT AREA SITE CLASS. P3 DESIGN FLOW 360 g/d L.T.A.R. 0.3 g/Ft²/d

Septic Tank: 1000 Gallons; STB 1000 Date 6-13-08

Pump Tank: Gallons; PT Date

Pump Make: Model Serial No.

Nitrification Field: No Fields 1 Square Feet = 1200 Linear Feet 300

No Lines 4 Trench Width 36" Max Trench Bottom Depth 36"

☑ New System ☐ Repair ☐ Expansion System Type: I II (III) IV V VI

System Description: 25% Reduction

Repair System Description: 25% Reduction

Maintenance Agreement Required: ☐ Yes ☑ No

Gravel Depth ☑ Gravity ☐ Pressure

☑ House/Mod. Home No. Bedrooms 3

☐ Mobile Home No. Persons

☐ Business No. Employees

☐ Other

Water Supply: ☑ Individual ☐ Public ☐ Community

☐ Slab ☑ Crawl Space ☐ Basement w/plumbing ☐ Basement wo/plumbing

Comments:/Conditions: Follow contour / Honor all setbacks.

Comments:/Conditions: Filter installed / Marker attached

INITIAL SITE SKETCH

See Attached Layout plan

AS BUILT SKETCH

Installed As Drawn

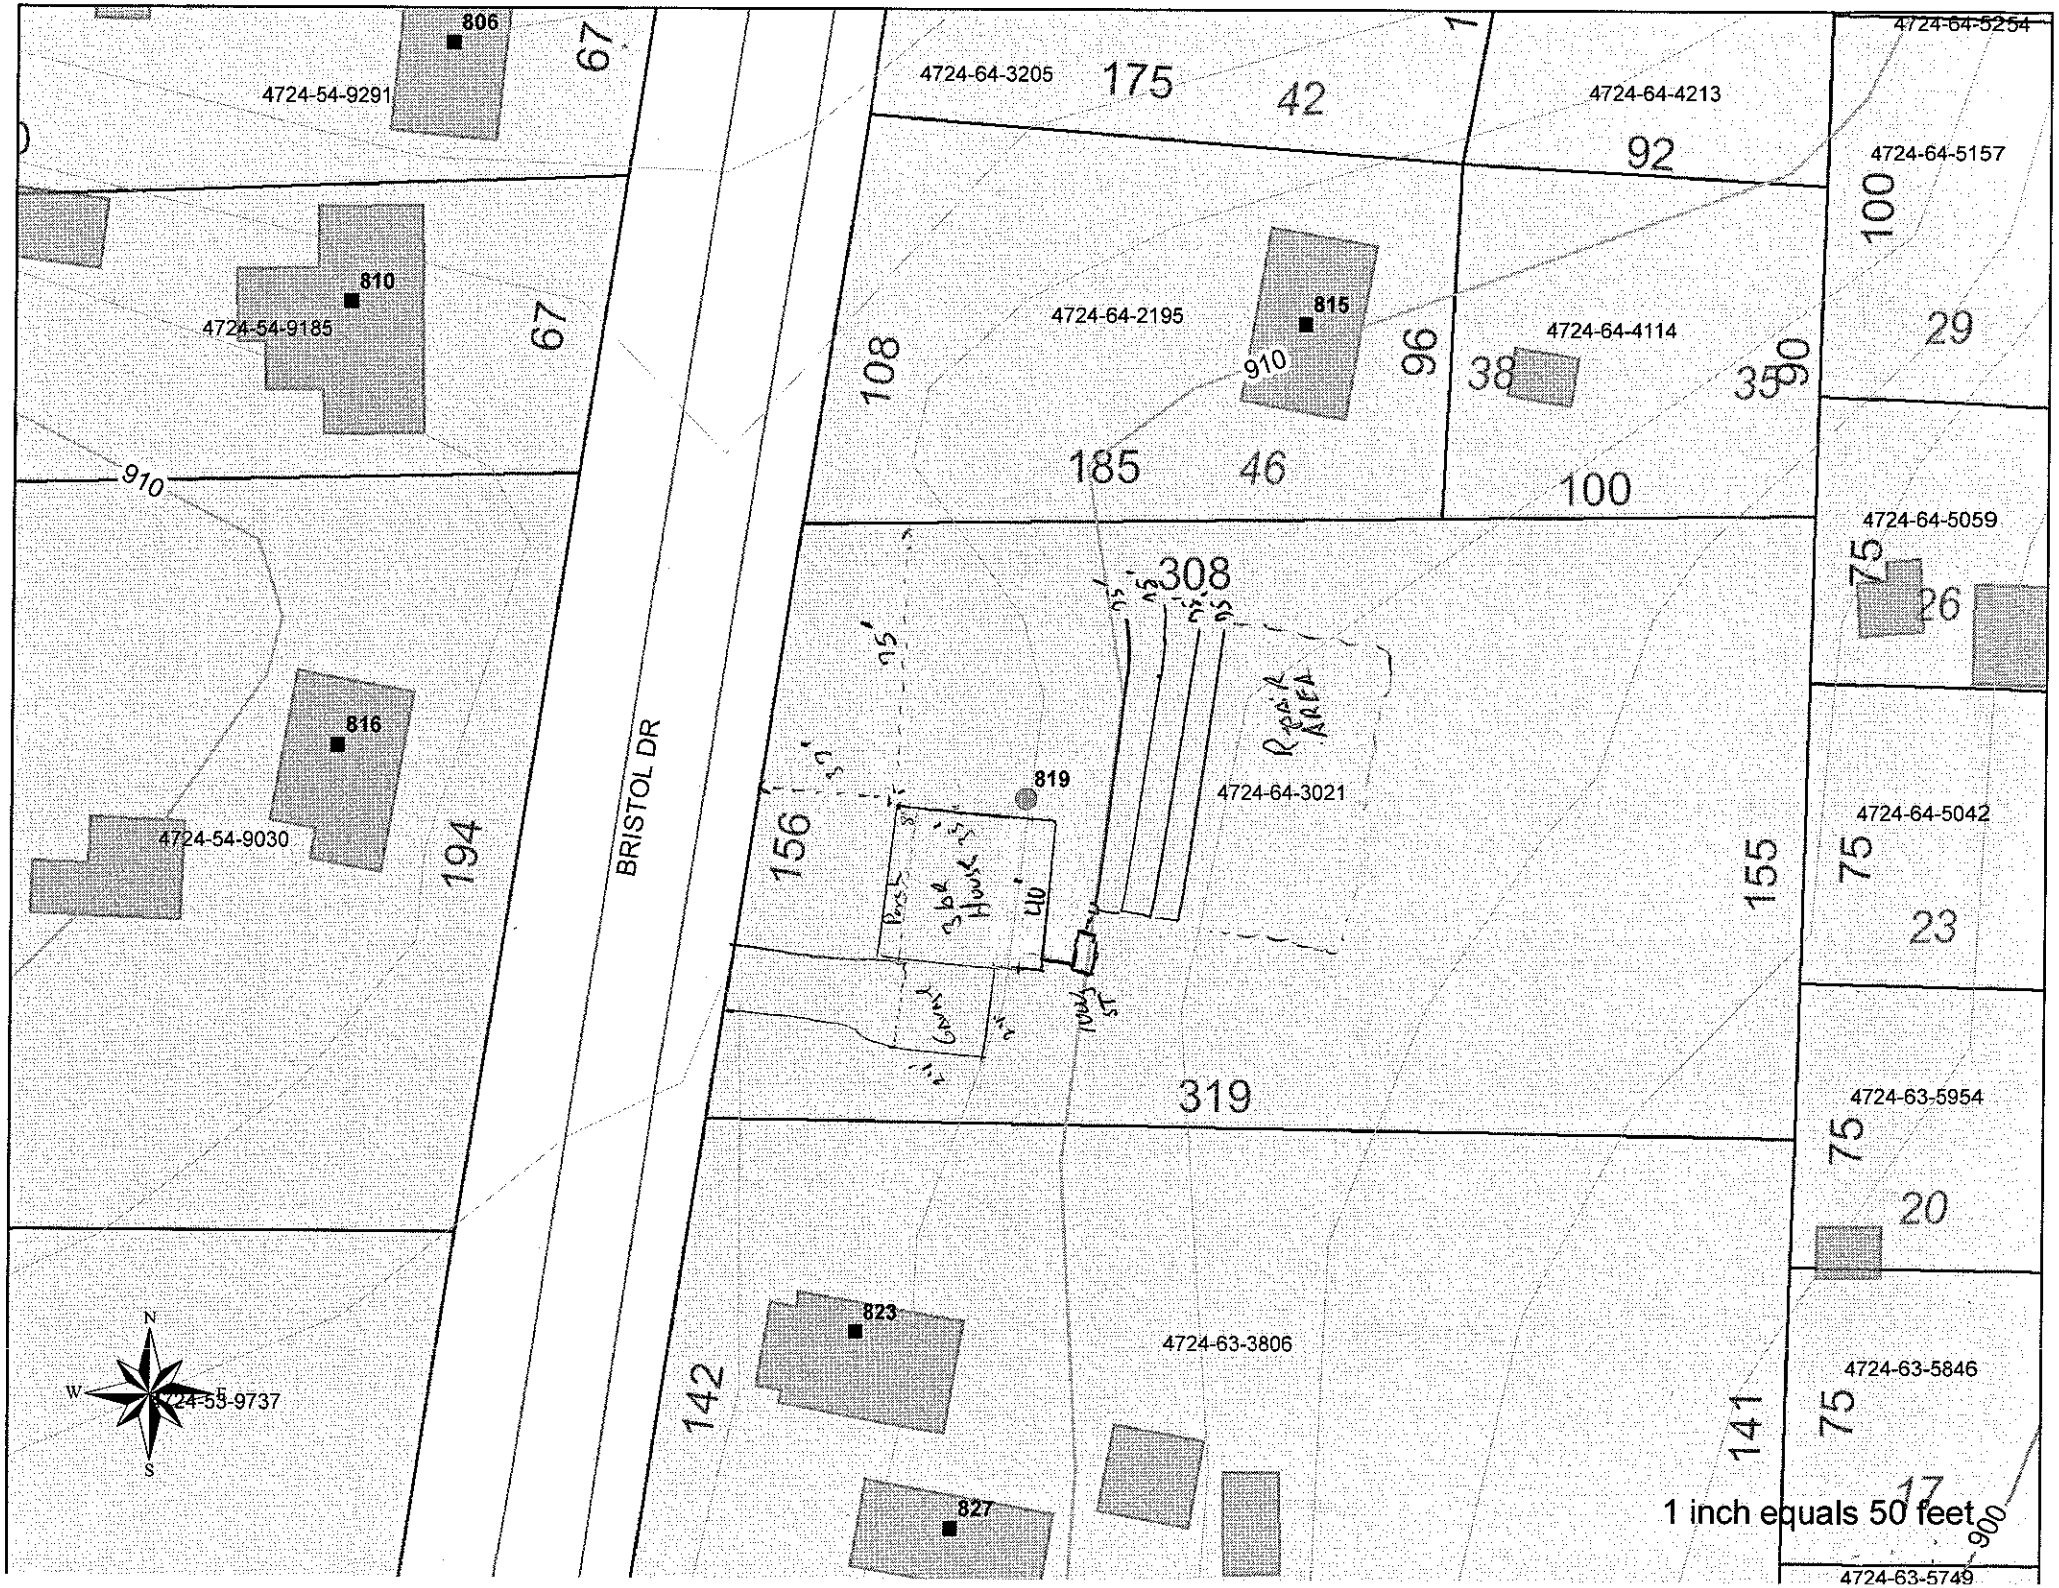
Permit can be suspended or revoked if any false information is supplied toward securing the permit/any unauthorized changes are made to the site/any unauthorized changes are made in the installation of the system. Improvement Permit with plat valid without expiration ☐ Improvement Permit with site plan valid for sixty months ☑ Authorization to Construct is valid for a period equal to that of Improvement Permit – not to exceed sixty months.

Signed: Todd C. Rhyne date Installed by: Jay Cothren

Improvement Permit by: R.S. date 31 March 08 Operation Permit by: R.S. date 31 March 08

Authorization to Construct by: R.S. date 31 March 08 Existing System Inspection by: date

HEALTH DEPT. COPY: WHITE OWNER COPY (FINAL): YELLOW OWNER COPY (INITIAL): PINK


806
4724-54-9291
67
4724-64-3205
175
42
1
4724-64-4213
92
4724-64-5254
4724-64-5157
100
29
810
4724-54-9185
67
108
4724-64-2195
815
910
96
4724-64-4114
38
35
90
910
185
46
100
4724-64-5059
75
26
308
816
BRISTOL DR
819
4724-64-3021
Repair AREA
4724-54-9030
194
156
155
4724-64-5042
75
23
319
4724-63-5954
75
20
N
W
E
S
823
4724-63-3806
142
141
4724-63-5846
75
17
827
1 inch equals 50 feet
900
4724-63-5749