ICHD - ENVIRONMENTAL HEALTH DIVISION

Statesville Office (704) 878-5305 x3456 | Mooresville Office (704) 660-3625 | SW

SEPTIC: IMPROVEMENT PERMIT / AUTHORIZATION TO CONSTRUCT / OPERATION PERMIT / EXISTING SYSTEM

PERMIT : OSWP 2024-61748

PIN # 4724 - 64 - 3685

APPLICANT/OWNER: Tracy Wessner

APPLICANT ADDRESS: 703 Bristol Dr. Statesville 28677

SITE ADDRESS: 703 Bristol Dr. Statesville 28677

PHONE:

ALT. PHONE

SITE DIRECTIONS: Hwy 70 E - (R) Bristol Dr - Lot on (R)

SAP CONTROLLED: ☐ YES ☐ NO

SUBDIVISION: C A Bolick

SECTION: -

LOT # 10-17

LOT AREA: -

DESIGN FLOW: EX.

L.T.A.R.(Initial): -

L.T.A.R (Repair): -

Septic Tank	1000	(gal)	STB		Date	☐ New System	☑ Repair	☐ Expansion	System Type: I II III IV V VI	☑ Residence	No. Bedrooms: Ex
Pump Tank		(gal)	PT		Date	System Description:				☐ Business	No. Persons: EX.
Pump Make			Model		Serial #	Repair System Description: Tank Replacement				☐ Other	No. Employees:
# Nitrification Fields	EXISTING		# Lines		Linear Ft	Maintenance Agreement Required:	☐ YES	☑ NO		☐ Slab	☐ Crawl Space
Trench Width			*Max. Trench Depth(Initial)		*Max. Trench Depth(Repair) -	Gravel Depth -	☑ GRAVITY	☐ PRESSURE		☑ Basement w/plumbing	☐ Basement w/o plumbing

Water Supply: ☑ Private ☐ Public ☐ Community

* Measured on the downhill side of the trench

Effluent Standard: ☑ DSE ☐ HSE ☐ TS-I ☐ TS-II ☐ RCW ☐ NSF/ANSI 40


Usable Depth to LC (Initial): -

Usable Depth to LC (Repair): - *Limiting Condition*

Comments / Conditions: Do not pave, grade, park, drive, or bury utilities in drainfield. Pump, crush, & fill old tank. New tank to be 15' off house.

System working properly at inspection. Replace distribution as needed.

INITIAL SITE SKETCH

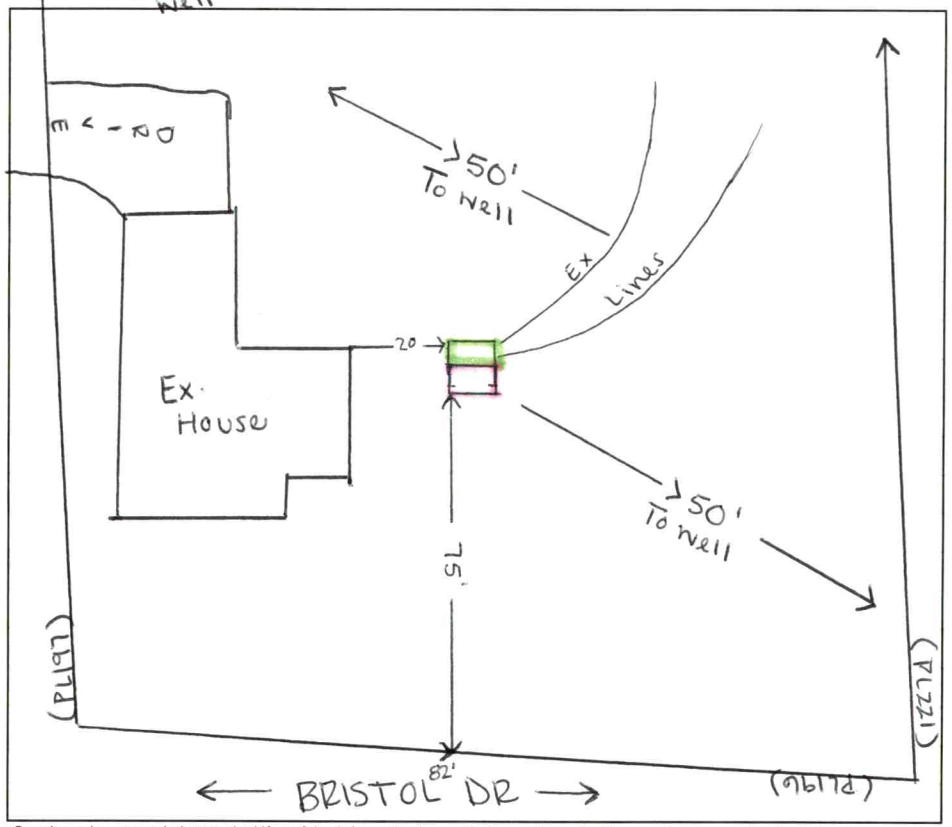

AS BUILT SKETCH

FOR SEPTIC FINAL INSPECTION CALL: 704-664-3703 between 8am-9am

the day the inspection is needed. Be sure to speak with an inspector to confirm your time.

1" = 40'

Ex. S.T to be pumped/crushed/filled

New Septic Tank

Neighbors Well

Permit can be suspended or revoked if any false information is supplied toward securing the permit / any unauthorized changes are made to the site / any unauthorized changes are made in the installation of the system. **CONTACT A LOCATOR SERVICE PRIOR TO ANY EXCAVATION**

☐ **IMPROVEMENT PERMIT** ***with plat*** *valid without expiration.* ☑ **IMPROVEMENT PERMIT** ***with site plan*** *valid for 60 mos.* ☑ **AUTHORIZATION TO CONSTRUCT** *valid for period equal to IMPROVEMENT PERMIT--not to exceed 60 mo.*

Owner / Applicant Signature: Online ✓ Date: -

Installed by: Piedmont Septic Solution ✓

IMPROVEMENT PERMIT by: Sydney Holland ✓ Date: 9/18/24

OPERATION PERMIT by: Bradley Moore ✓ Date: 10/4/24

AUTHORIZATION TO CONSTRUCT by: Sydney Holland ✓ Date: 9/18/24


Existing System Inspected by: Date:

Item	Date	Initials
Drain Lines Checked		
Tanks Checked		
Pressure Manifold or Valve Box Checked		
Pressure Head Set		
Electrical Checked		
Floats Set		
Alarm Checked		
Maintenance Contract Needed? Y / N		
Comments:		

Repairs Only	
	State Code
Failing System Code	
Type of Distribution	G or P
Type of Failure/Malfunction	
Primary Cause of Failure/Malfunction	
Age of System? _____	
Initial or Repair? _____	

Iredell County, North Carolina

September 18, 2024

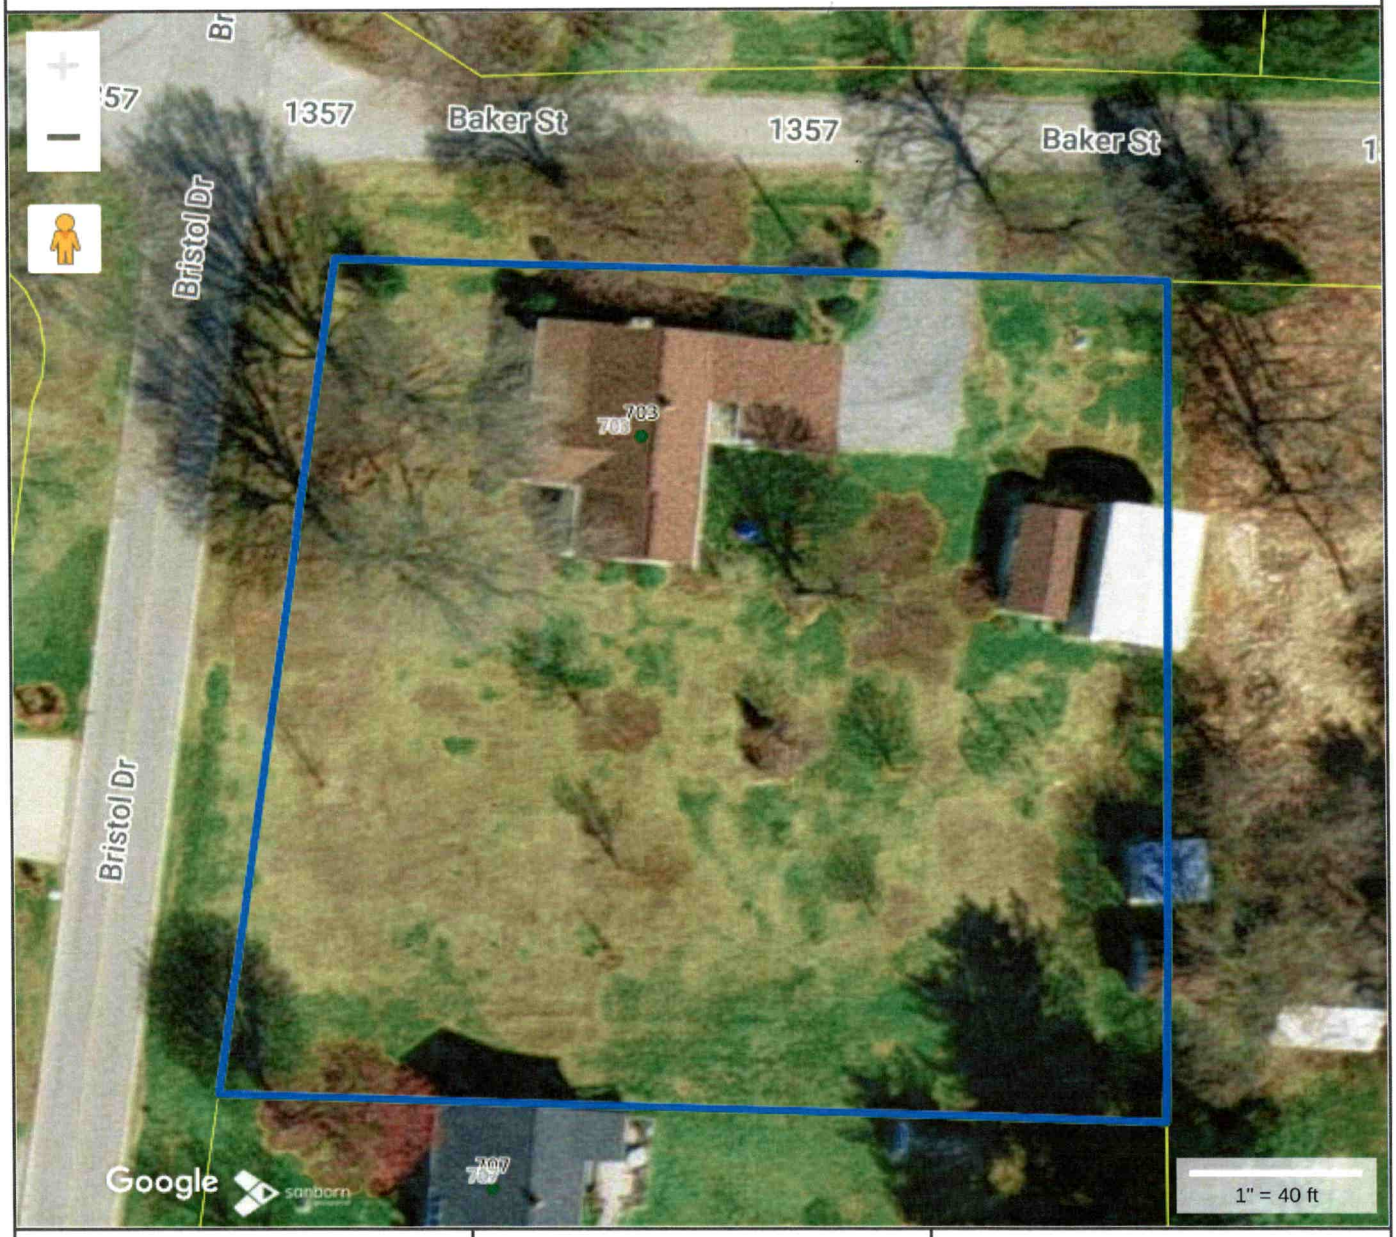

Tax Map Information

• PIN	4724643685.000
• Address	703 BRISTOL DR
• Account #	Acct 11041250
• Tax Owner	CARTER ROBERT F
• Mailing Address	126 WALKER VALLEY DR
•	STONY POINT, NC 28678
• GIS Owner	CARTER ROBERT F
• Deed Info	547 / 127 - WD - 19731001
• Tax Acres	0 LT
• Lot #	10-17
• Description	C A BOLICK BLKB PB4-7
• Zoning	R-20
• Old Parcel #	0206E02000B010
• Bldg Value	$122,850
• OBXF Value	$1,990
• Land Value	$26,000
• Total Value	$150,840
• Defer Value	$0
• Tax Districts	-ALLCNTY FIRE- -

IREDELL COUNTY, NC

MAP FOR REFERENCE ONLY
NOT A LEGAL DOCUMENT

Iredell County, North Carolina makes no claims and no warranties, expressed or implied, concerning the validity or accuracy of the GIS data presented on this map.

Geometry updated 09/12/2024
Data updated 09/12/2024

Print map scale is approximate. Critical layout or measurement activities should not be done using this resource.