IREDELL COUNTY HEALTH DEPARTMENT - *ENVIRONMENTAL HEALTH* ☑ STATESVILLE OFFICE 704-878-5305 ☐ MOORESVILLE OFFICE 704-664-5281

IMPROVEMENT PERMIT / AUTHORIZATION TO CONSTRUCT / OPERATION PERMIT / EXISTING SYSTEM INSPECTION

PERMIT # R-2011 PIN # 4724-65-2103 DATE 22 February 2011

OWNER Ivan Wrestle APPLICANT: PHONE: Home/Cell # (704) 450-6482 Business #

SITE ADDRESS 614 Bristol Drive Statesville OWNER / APPLICANT ADDRESS 396 Freemont Rd Denson 27017

SITE DIRECTIONS Corner Bagwell - Turn Bristol Drive, on Rt. past Ag. Office.

SUBDIVISION BLOCK / SECTION LOT # LOT AREA 0.69Ac. DESIGN FLOW 240 gpd L.T.A.R. 0.3 gal/ft²/d

Septic Tank 1000 Gallons: STB 725 Date 11/11/10 ☐ New System ☑ Repair ☐ Expansion System Type I II III IV V VI

Pump Tank Gallons: P T Date System Description: 25% Reduction System

Pump Make Model Serial # Repair System Description:

No. Nitrification Fields: 1 No. Lines 4 Linear Feet 200 Maintenance Agreement Required ☐ YES ☑ NO

Trench Width 36" Max. Trench Bottom Depth 36" Gravel Depth N/A ☑ GRAVITY ☐ PRESSURE

☑ Residence No. Bedrooms 2 Water Supply

☐ Business No. Persons ☑ Private


☐ Other No. Employees ☐ Public

☐ Slab ☐ Crawl Space ☐ Community


☐ Basement w/plumbing ☑ Basement w/o plumbing

Comments / Conditions * Keep 50' From all wells / Property Abandon old septic system.

INITIAL SITE SKETCH

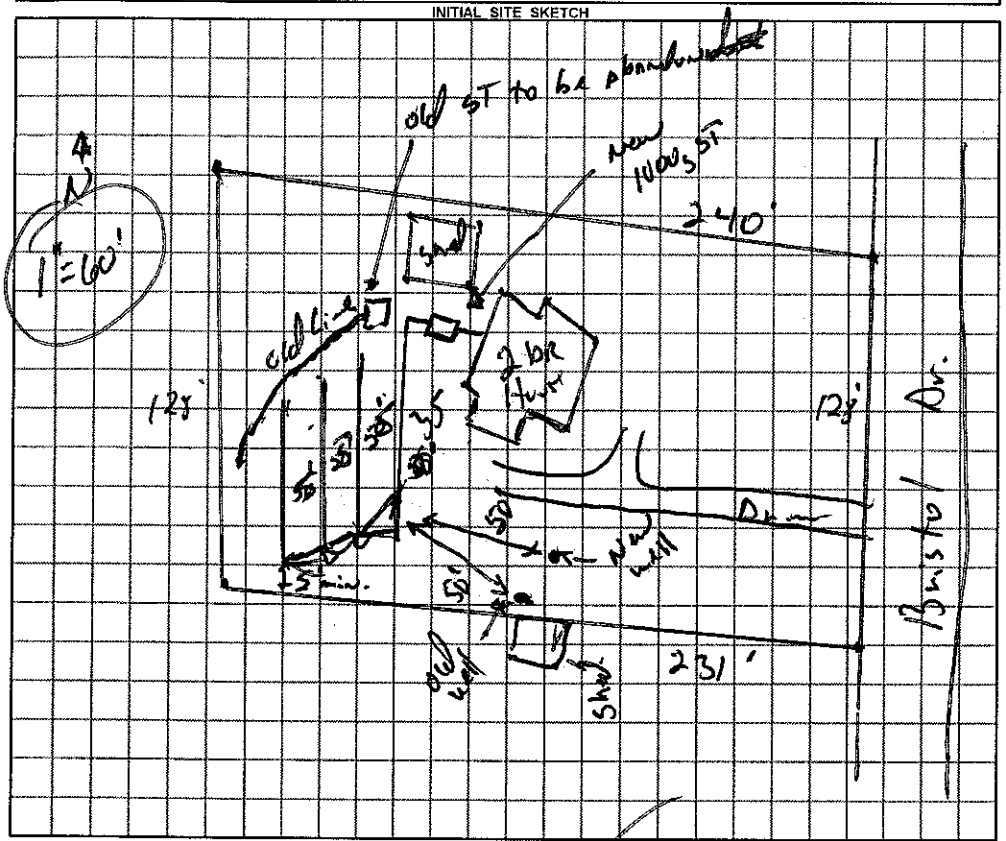

AS BUILT SKETCH

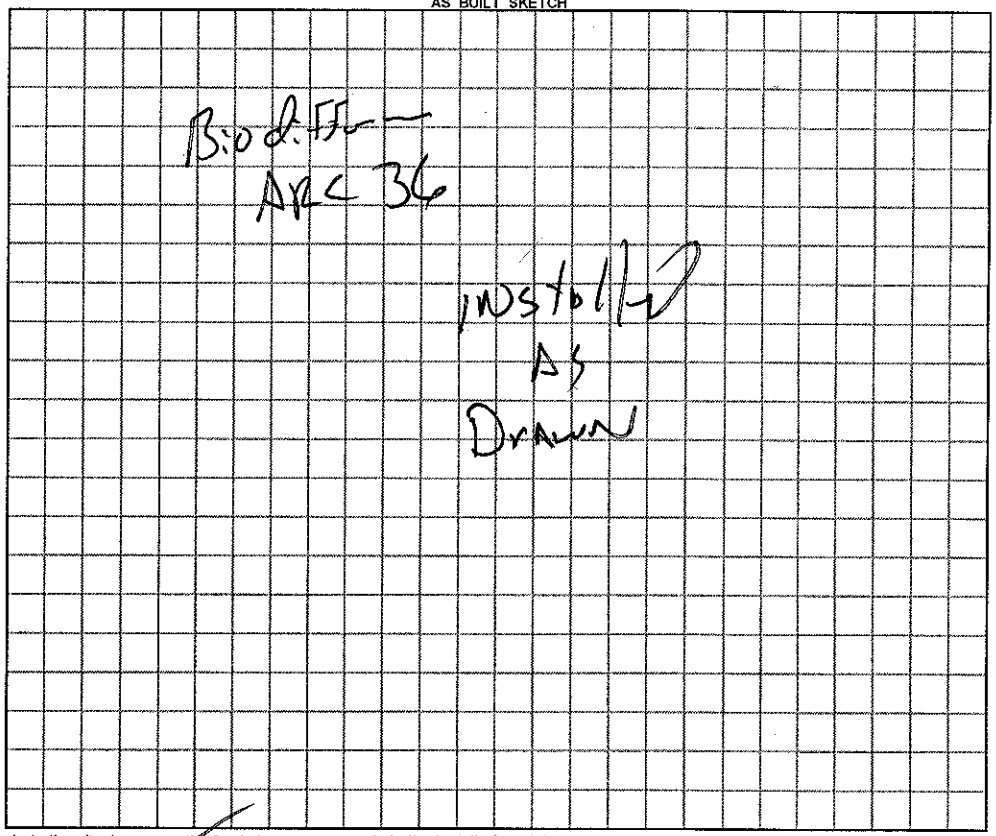

Permit can be suspended or revoked if any false information is supplied toward securing the permit / any unauthorized changes are made to the site / any unauthorized changes are made in the installation of the system.

☐ ***IMPROVEMENT PERMIT*** with plat valid without expiration. ☑ ***IMPROVEMENT PERMIT*** with plat valid ~~without expiration~~. ☑ ***AUTHORIZATION TO CONSTRUCT*** valid for period equal to IMPROVEMENT PERMIT--not to exceed 60 mo.

Owner / Applicant Signature: Danny Lankford Date 2-22-11 (60 mos.) Installed by: James Miller

IMPROVEMENT PERMIT by: REHS Date 22 Feb. 11 OPERATION PERMIT by: REHS Date 23 Feb. 11

AUTHORIZATION TO CONSTRUCT by: REHS Date 22 Feb. 11 Existing System Inspected by: REHS Date

YOU SHOULD CONTACT A LOCATOR SERVICE PRIOR TO ANY EXCAVATION

White Copy – Environmental Health YELLOW COPY (Final) Owner / Applicant PINK COPY (Initial) Owner / Applicant