1:00

IREDELL COUNTY HEALTH DEPARTMENT

CI

STATESVILLE 704-878-5305 MOORESVILLE 704-664-5281

IMPROVEMENT PERMIT / AUTHORIZATION TO CONSTRUCT / OPERATION PERMIT / EXISTING SYSTEM INSPECTION

PERMIT # 171919 PIN # 4724-65-5989 DATE APRIL 30, 2012

OWNER or APPLICANT MELANIE STROUD PHONE: Business c/o 704-239-3693 Home:

OWNER or APPLICANT ADDRESS 507 BRISTOL DRIVE, STATESVILLE, NC 28677

LOCATION / DIRECTIONS I-40 W, TL W. FRONT STREET, TR BRISTOL DRIVE, LOT ON LEFT AT BOX #507

SUBDIVISION BLOCK / SECTION LOT # 1 LOT AREA 0.839Ac DESIGN FLOW 360 L.T.A.R. 0.30 GPD/FT2

Septic Tank 1000 Gallons: STB 760 Date 11-19-11
Pump Tank Gallons: P T Date
Pump Make Model Serial #
Nitrification Field No Fields 1 No Lines 3 Linear Feet 300
Trench Width 36" Max. Trench Bottom Depth 36" Gravel Depth N/A

☑ New System ☐ Repair ☐ Expansion System Type I II III IV V VI
System Description: 25% REDUCTION, GRAVITY
Repair System Description: 25% REDUCTION, GRAVITY
Maintenance Agreement Required ☐ YES ☑ NO
☑ GRAVITY ☐ PRESSURE


☑ Residence No. Bedrooms 3
☐ Business No. Persons
☐ Other No. Employees
☐ Slab ☑ Crawl Space
☐ Basement w/plumbing ☐ Basement w/o plumbing

Water Supply
☑ Private WELL
☐ Public
☐ Community

Comments / Conditions: INSTALL 25% REDUCTION SYSTEM ON CONTOUR AS SHOWN USING SERIAL DISTRIBUTION.

Comments / Conditions: ARC36

INITIAL SITE SKETCH

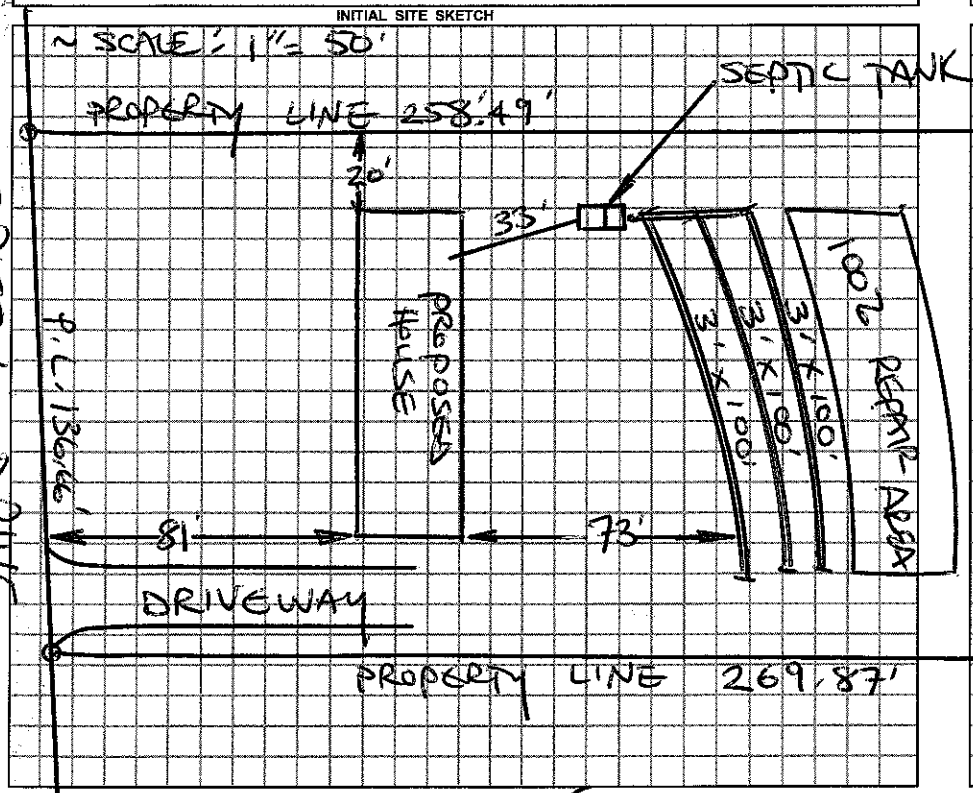

AS BUILT SKETCH

Permit can be suspended or revoked if any false information is supplied toward securing the permit / any unauthorized changes are made to the site / any unauthorized changes are made in the installation of the system.

☐ IMPROVEMENT PERMIT w / plat valid without expiration ☑ IMPROVEMENT PERMIT w / site plan valid for 60 mos. ☑ AUTHORIZATION TO CONSTRUCT valid for period equal to IMPROVEMENT PERMIT-not to exceed 60 mo.

Owner / Applicant Signature: Melanie Stroud Date 5/2/12

Improvement Permit by: STEVE HEDRICK Date 4-30-12

Authorization to Construct by: STEVE HEDRICK Date 4-30-12

YOU SHOULD CONTACT A LOCATOR SERVICE PRIOR TO ANY EXCAVATION.

Installed by: Abee Grading

Operation Permit by: Date: 5-24-12

Existing System Inspected by: Date:

WHITE COPY Environmental Health YELLOW COPY (Final) Owner / Applicant PINK COPY (Initial) Owner / Applicant