070649

This permit voids permit dated 10-20-97

IREDELL COUNTY HEALTH DEPARTMENT

STATESVILLE 704-878-5305 MOORESVILLE 704-664-5281

IMPROVEMENT PERMIT / AUTHORIZATION TO CONSTRUCT / OPERATION PERMIT / EXISTING SYSTEM INSPECTION

PERMIT# Statesville City PIN# 4724567198 DATE 9-15-98

OWNER OR CONTRACTOR Church of God of Prophecy PHONE: Business _____ Home 878-0386

ADDRESS 504 Bristol Dr. Statesville

LOCATION 90 TR Bristol Drive Behind Church

SUBDIVISION _____ BLOCK / SECTION _____ LOT _____ LOT AREA 20,000 SITE CLASS. P/S DESIGN FLOW 360 L.T.A.R. 0.3

Septic Tank: 1000 Gallons; STB 1012 Date 10-17-98
Pump Tank: _____ Gallons; PT _____ Date _____
Pump Make: _____ Model _____ Serial No. _____
Nitrification Field: No Fields 1 Square Feet 1200 Linear Feet 400
No Lines 4 Trench Width 36in Max Trench Bottom Depth 36in

[X] New System [ ] Repair System Type: I, II, III, IV, V, VI
System Description: Gravity Conventional
Repair System Description: 8 Pump/Gravity Comb
Maintenance Agreement Required: [ ] Yes [ ] No


[X] House/Mod. Home No. Bedrooms 3
[ ] Mobile Home No. Bathrooms 2
[ ] Business No. Employees ____
[ ] Other _____
[ ] Slab [X] Crawl Space [ ] Basement w/plumbing [ ] Basement wo/plumbing

Water Supply: [X] Individual [ ] Public [ ] Community shared well

Comments:/Conditions: Keep lines on contour keep water line 10ft from any system.

Comments:/Conditions:

INITIAL SITE SKETCH

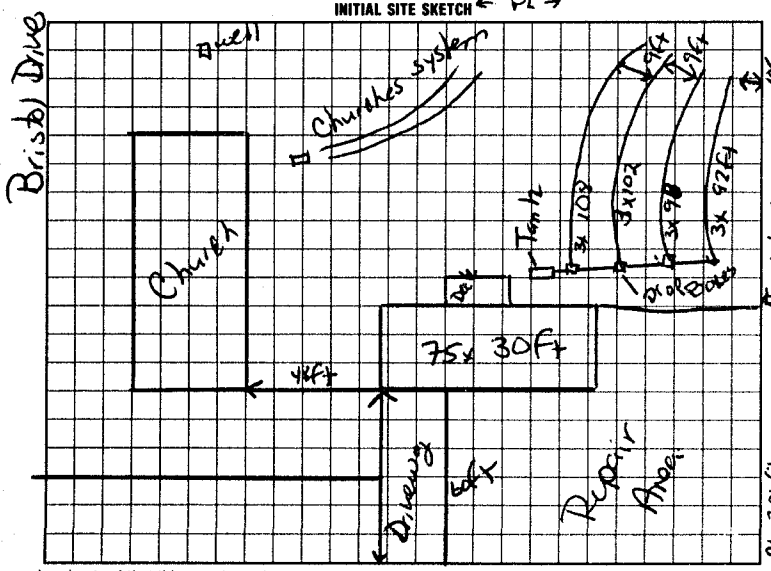

AS BUILT SKETCH

SYSTEM INSTALLED USING FOUR 100 FOOT LINES

I understand that this permit can be suspended or revoked if any false information is supplied toward securing the permit/any unauthorized changes are made to the site/any unauthorized changes are made in the installation of the system. Improvement Permit with plat valid without expiration. Improvement Permit with site plan valid for sixty months. Authorization to Construct is valid for a period equal to that of Improvement Permit – not to exceed sixty months.

Signed: Bill Long date 9-16-98

Improvement Permit by: Mark Cox RS date 9-15-98

Authorization to Construct by: Mark Cox RS date 9-15-98

Installed by: A-1 BACKHOE

Operation Permit by: STEVE HEDRICK date 1-6-99

Existing System Inspection by: _____ date _____

HEALTH DEPT. COPY: WHITE INSPECTION COPY (FINAL) GREEN OWNER COPY (FINAL) YELLOW INSPECTION COPY (INITIAL) PINK OWNER COPY (INITIAL): GOLD