IREDELL COUNTY HEALTH DEPARTMENT

(SEPTIC TANK) IMPROVEMENTS PERMIT AND CERTIFICATE OF COMPLETION
(Ground Absorption Sewage Disposal System – G. S. Chapter 130-Article 13C)

OWNER OR CONTRACTOR Vander Redmond DATE Jan 27, 1977 PERMIT NO. _____

PHONE: Business _____ Home _____

LOCATION 90 N, T. Lion Bristol Drive, go 4 mile, white frame house on Rt S. R. No. _____

SUBDIVISION NAME _____ LOT NO. _____ SECTION OR BLOCK NO. _____

House (✓) Mobile Home ( ) Business ( ) Other _____


No. Bedrooms _____ No. Bathrooms _____

Garbage Disposal Unit	Yes ( )	No ( )	
Auto. Dishwasher	Yes ( )	No ( )	
Auto. Wash. Machine	Yes ( )	No ( )	
Site Suitable	Yes ( )	No ( )	

Lot Area _____

Character & Porosity of Soil _____
Percolation Rate _____
Topography _____
Depth to Water Table _____
Rock or other impervious formations _____

Repair

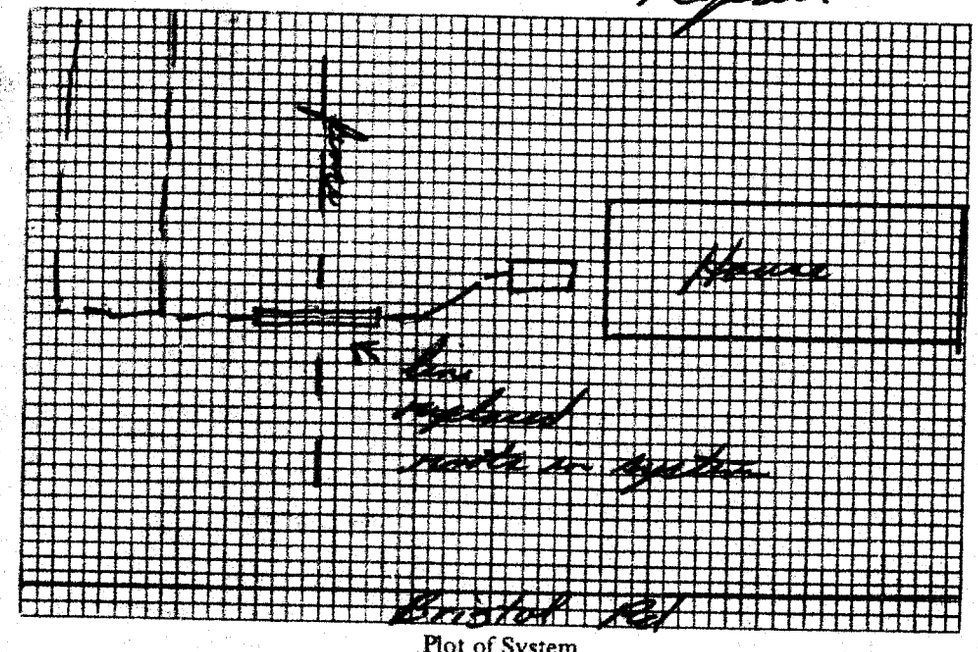

Plot of System

Size of Tank existing Gals.
Nitrification Field:
No. of Lines 1
Sq. Ft. _____ Linear Ft. 20'
Depth of Stone in Lines _____
Water Supply: Individual ( )
Public ( )

Installed by Wes Lytton

IMPROVEMENTS PERMIT BY Andrew E. Causey

COMMENTS: Roots stopped up pipe, at fence, new pipe was installed

CERTIFICATE OF COMPLETION BY Andrew E. Causey DATE 6/27/77

CONSTRUCTION MUST COMPLY WITH ALL OTHER APPLICABLE STATE AND LOCAL REGULATIONS.

Health Dept. Copy: White Inspection Dept. Copy: Yellow Sanitarian's Copy: Pink Owner's Copy: Gold