IREDELL COUNTY HEALTH DEPARTMENT

Statesville Phone TR 3-7271 Mooresville Phone NO 3-1271

PERMIT TO INSTALL SEPTIC TANK

Permit NO. _____ Permit Date Jan 10 - 1963

Owner Sherrill Lumber Co. Address Bristol Rd.

Installed By C H & K Address _____


Location of Property Green Crest - off Tayb Rd. on Bristol Rd. ½ Mile. At entrance to Green Crest.

Tank		Capacity		Length of Lines		Fixtures	
Block	( )	800	( )	150'	( )	No. of Baths	(2)
Precast	(✓)	900	( )	175'	( )	Dishwasher	( )
		1000	(✓)	200'	( )	Garbage Grdr.	( )
		1100	( )	225'	(✓)	Auto-Washer	(✓)
		1200	( )	250'	( )	Other	_____
		Other	_____	Other	_____		

NOTIFY HEALTH DEPARTMENT AT LEAST EIGHT HOURS BEFORE TANK IS TO BE INSPECTED.

Final Inspection 1-10 1963 Approved (✓) Disapproved ( )

Remarks well 501 - [redacted] well next door 501

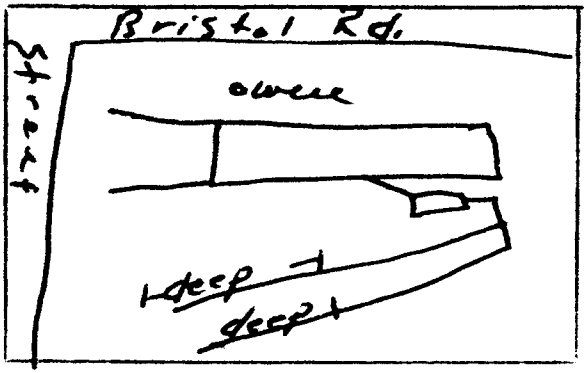

Sketch of Installation

Sanitarian