IREDELL COUNTY HEALTH DEPARTMENT

STATESVILLE 704-878-5305 MOORESVILLE 704-664-5281

2:30 58462

IMPROVEMENT PERMIT / CERTIFICATE OF COMPLETION / OPERATION PERMIT / EXISTING SYSTEM INSPECTION

PROPERTY DESCRIPTION NO. Statesville DATE 11-1-95 TAX MAP NO. 6K-9A PT 5+52 Watershed: ☐ Yes ☐ No

OWNER OR CONTRACTOR Evie Hoile PHONE: Business Home

ADDRESS 425 Bristol Rd

LOCATION 90 W Turn Bristol Rd 1/4mi left

SUBDIVISION J.L. Sherrill BLOCK / SECTION LOT 1 LOT AREA 115 X 339' SITE CLASS. RS DESIGN FLOW 360 L.T.A.R. 13

Property

Septic Tank: 1000 Gallons; ST 794 Date 8-30-95

Pump Tank: Gallons; PT Date

Pump Make: Model Serial No.

Nitrification Field: No Fields 1 Square Feet 1200 Linear Feet 400

No Lines 4 Trench Width 36 Max Trench Bottom Depth 36 Gravel Depth 12"

☑ New System ☐ Repair System Type: I, II, III, IV, V, VI

System Description: Conv. Gravity

Repair System Description: " "

Maintenance Agreement Required: ☐ Yes ☑ No

☐ House/Mod. Home No. Bedrooms 3

☑ Mobile Home No. Bathrooms 2

☐ Business No. Employees

☐ Other

☐ Slab ☑ Crawl Space ☐ Basement w/plumbing ☐ Basement wo/plumbing


Water Supply: ☑ Individual ☐ Community ☐ Public

Comments:


Keep well at least 100' from ST. System in front Yard

Comments:

INITIAL SITE SKETCH or Repair 3401

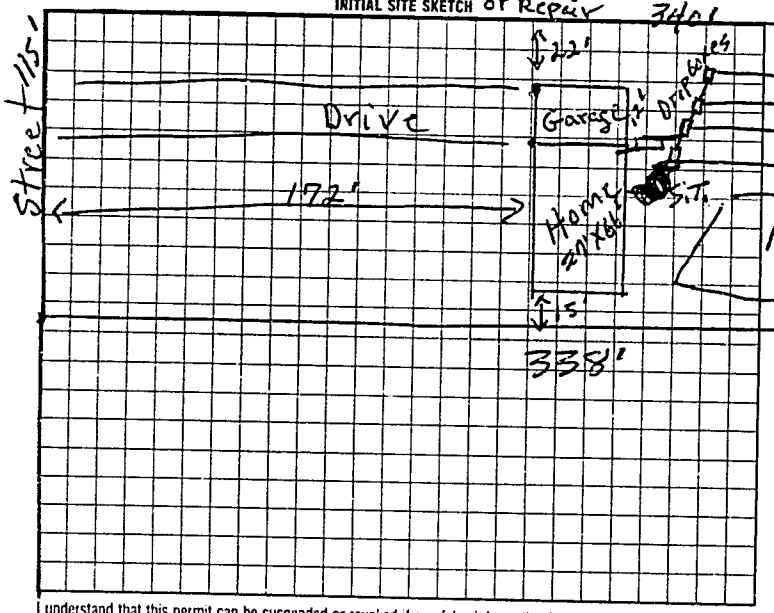

AS BUILT SKETCH

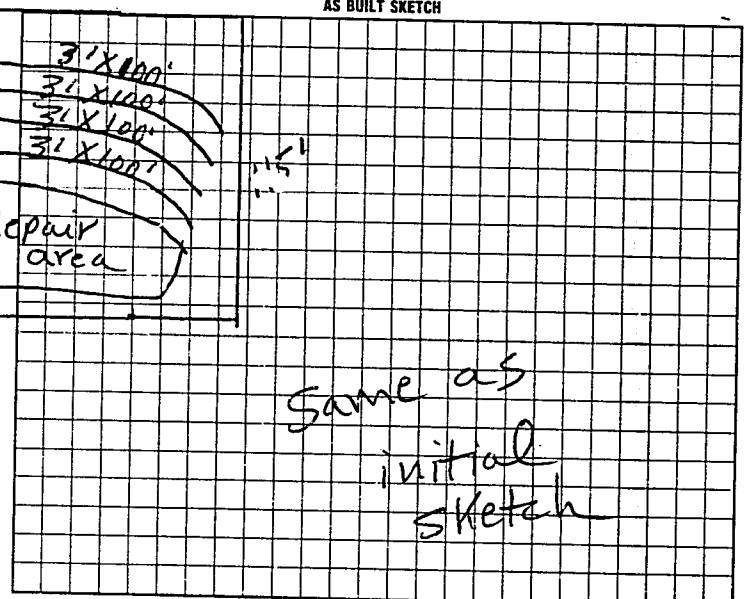

I understand that this permit can be suspended or revoked if any false information is supplied toward securing the permit/any unauthorized changes are made to the site/any unauthorized changes are made in the installation of the system.

Signed: x Evie D Hoile

Improvement Permit by: C. Moore date 11-1-95

Existing System Inspection / Authorization to Const. by: C. Moore date 11-1-95

Installed by: A-1 Backhoe

Certificate of Completion by: date

Operation Permit by: C. Moore date 11-21-95

HEALTH DEPT COPY WHITE INSPECTION COPY (FINAL) GREEN OWNER COPY (FINAL) YELLOW INSPECTION COPY (INITIAL) PINK OWNER COPY (INITIAL) GOLD

Authorization to Const. Expires 60 mos from date of issue