67282 → Robert Radford

IREDELL COUNTY HEALTH DEPARTMENT

STATESVILLE 704-878-5305 MOORESVILLE 704-664-5281

IMPROVEMENT PERMIT / CERTIFICATE OF COMPLETION / OPERATION PERMIT / EXISTING SYSTEM INSPECTION

PROPERTY DESCRIPTION NO. STATESVILLE DATE 12-5-96 TAX MAP NO. 6K-9-A-51,52,55,55A / 6K-10-A-10,11 Watershed: ☐ Yes ☑ No

OWNER OR CONTRACTOR DONNIE WALKER PHONE: Business 873-1431 Home

ADDRESS 249 PRESSLY FARM ROAD STATESVILLE NC 28678

LOCATION BRISTOL DRIVE TL GREENCREST; TL CENTER DRIVE, TL BRIDLE LANE, AT END ON LEFT

SUBDIVISION SHERRILL ESTATES BLOCK / SECTION II LOT 18 LOT AREA 21,779 Ft² SITE CLASS. PS DESIGN FLOW 360 L.T.A.R. 0.30 GPD/Ft²

Septic Tank: 1000 Gallons; STB 1012 Date 2-17-97

Pump Tank: 1000 Gallons; PT 1 Date 10-21-96

Pump Make: Gould Model WE05111 Serial No. C97423127

Nitrification Field: No Fields 1 Square Feet EQ TO 1200 Linear Feet 200

No Lines FOUR Trench Width 24 Max Trench Bottom Depth 32-36"

☑ New System ☐ Repair System Type: I, II, III, IV, V, VI

System Description: PPBPS, PUMP

Repair System Description: PPBPS, PUMP

Maintenance Agreement Required: ☐ Yes ☑ No

Gravel Depth 6" ☐ Slab ☑ Crawl Space ☐ Basement w/plumbing ☐ Basement wo/plumbing

☐ House/Mod. Home No. Bedrooms 3

☑ Mobile Home No. Bathrooms 2

☐ Business No. Employees


☐ Other

Water Supply: ☑ Individual ☐ Community ☐ Public WELL

Comments: ① CONTACT HEALTH DEPT. TO FLUSH SYSTEM PRIOR TO INSTALLATION ② INSTALL 4 PPBPS PANELS IN FOUR EQUAL LENGTH LINES ③ SEE ATTACHED SHEETS FOR PUMP & PRESSURE MANIFOLD REQUIREMENTS

Comments: AREA TO BE LANDSCAPED TO PROVIDE ADEQUATE DRAINAGE AWAY FROM TANKS & LINES.

INITIAL SITE SKETCH SCALE: 1" = 40'

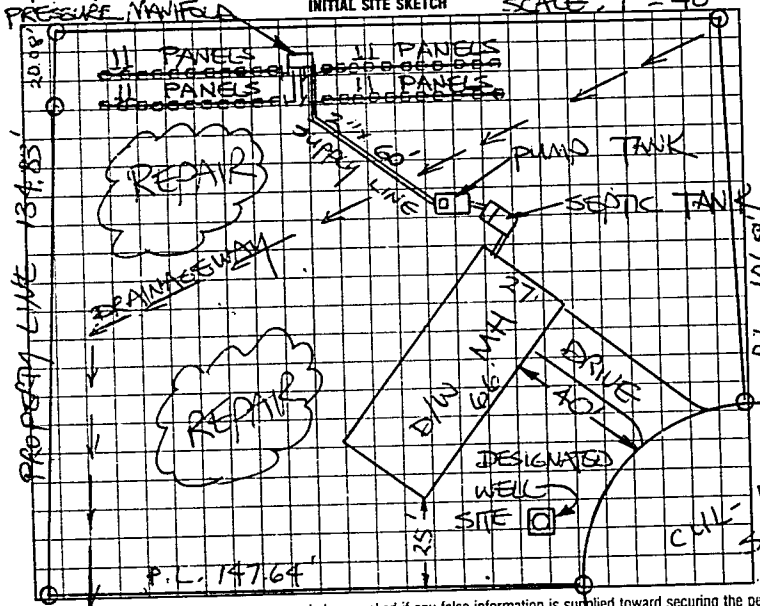

NOTE: MEASURE THIS LINE PRIOR TO INSTALLATION

AS BUILT SKETCH

5-2 Checked lines
Pump cycle
weld to check alarm (mounted)
- raiser Depth

SYSTEM INSTALLED ACCORDING TO INITIAL SITE SKETCH

I understand that this permit can be suspended or revoked if any false information is supplied toward securing the permit/any unauthorized changes are made to the site/any unauthorized changes are made in the installation of the system.

Auth. to Const. is valid for a period equal to the validity of the IP not to exceed five years. IP w/site plan is valid five years.

Signed: [signature] Installed by: Donald Lackey

Improvement Permit by: STEVE HEDRICK date 12-5-96 Certificate of Completion by: date

Authorization to Construct XXXXXXXXXXXXXXXXXXXX by: STEVE HEDRICK date 12-5-96 Operation Permit by: STEVE HEDRICK date 5-22-97

HEALTH DEPT. COPY: WHITE INSPECTION COPY (FINAL): GREEN OWNER COPY (FINAL): YELLOW INSPECTION COPY (INITIAL) PINK OWNER COPY (INITIAL) GOLD

00231