IREDELL COUNTY HEALTH DEPARTMENT

STATESVILLE 704-878-5305 MOORESVILLE 704-664-5281

IMPROVEMENT PERMIT / AUTHORIZATION TO CONSTRUCT / OPERATION PERMIT / EXISTING SYSTEM INSPECTION

PERMIT# REPAIR PIN# 4724-66-9355 DAVID TURNER DATE 4-20-05

OWNER OR CONTRACTOR VIRGINIA T. SUMMERS PHONE: Business 704-437-1643 Home 704-664-5253

ADDRESS 2610 GREENCREST LANE, STATESVILLE, NC 28677

LOCATION US 70 WEST, TR BRISTOL DRIVE TR GREENCREST LANE, HOUSE ON LEFT AT #2610

SUBDIVISION GREENCREST BLOCK / SECTION ____ LOT 49' LOT AREA 0.29 ACRE SITE CLASS 1PS DESIGN FLOW 360 L.T.A.R. EXISTING

Septic Tank: 1000 Gallons; STB 1007 Date 3-20-05
Pump Tank: ____ Gallons; PT ____ Date ____
Pump Make: ____ Model ____ Serial No. ____
Nitrification Field: No Fields 1 Square Feet ____ Linear Feet EXISTING
No Lines EXISTING Trench Width ____ Max Trench Bottom Depth ____ Gravel Depth ____

☐ New System ☑ Repair System Type: I (II) III, IV, V, VI
System Description: ____
Repair System Description: CONVENTIONAL, GRAVITY
Maintenance Agreement Required: ☐ Yes ☑ No


☑ House/Mod. Home No. Bedrooms 3
☐ Mobile Home No. Bathrooms ____
☐ Business No. Employees ____
☐ Other ____
☐ Slab ☐ Crawl Space ☑ Basement w/plumbing ☐ Basement wo/plumbing

Water Supply: ☑ Individual ☑ Public ☐ Community


Comments:/Conditions: INSTALL NEW SEPTIC TANK WITH RISERS AT LOCATION SHOWN. PUMP-OUT, CRUSH AND FILL EXISTING SEPTIC TANK. TIE EXISTING DRAIN-FIELD TO NEW SEPTIC TANK W/ 3" SCH 40 PVC

Comments:/Conditions: SEPTIC TANK WITH MARKER INSTALLED USING "ZABEL" FILTER

INITIAL SITE SKETCH

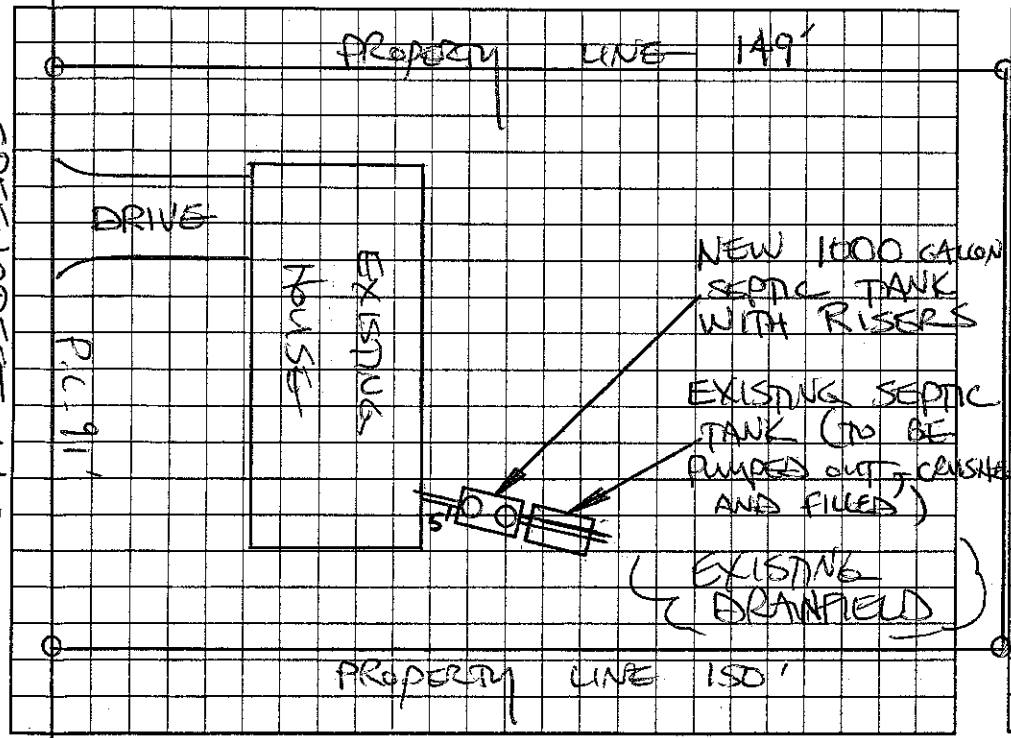

AS BUILT SKETCH

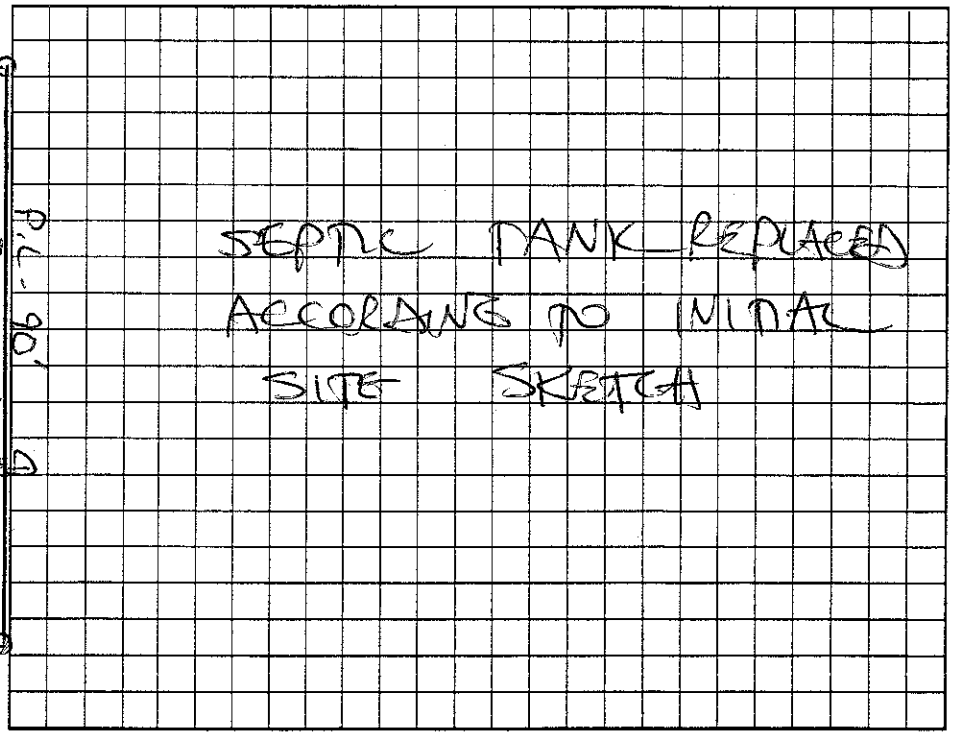

Permit can be suspended or revoked if any false information is supplied toward securing the permit/any unauthorized changes are made to the site/any unauthorized changes are made in the installation of the system. Improvement Permit with plat valid without expiration. Improvement Permit with site plan valid for sixty months. Authorization to Construct is valid for a period equal to that of Improvement Permit – not to exceed sixty months.

Signed: [signature] date 4-20-05 Installed by: IREDELL BACKHOE

Improvement Permit by: STEVE HENDRICK date 4-20-05 Operation Permit by: STEVE HENDRICK date 5-3-05

Authorization to Construct by: STEVE HENDRICK date 4-20-05 Existing System Inspection by: ____ date ____

HEALTH DEPT. COPY: WHITE OWNER COPY (FINAL): YELLOW OWNER COPY (INITIAL): PINK