IREDELL COUNTY HEALTH DEPARTMENT - *ENVIRONMENTAL HEALTH* ☑ STATESVILLE OFFICE 704-878-5305 ☐ MOORESVILLE OFFICE 704-664-5281

IMPROVEMENT PERMIT / AUTHORIZATION TO CONSTRUCT / OPERATION PERMIT / EXISTING SYSTEM INSPECTION

PERMIT # REPAIR PIN # 4724-68-0972 DATE MAY 8 2012

OWNER LOFLAND & RUMMAGE APPLICANT: SAME PHONE: Home/Cell # 704-873-4921 Business #

SITE ADDRESS 208 C STREET OWNER / APPLICANT ADDRESS P.O. BOX 5967, STATESVILLE, NC 28687

SITE DIRECTIONS WESTMINSTER DRIVE TO C STREET 2ND HOUSE ON LEFT


SUBDIVISION J.W. SHERRILL BLOCK / SECTION NA LOT # 166/7 LOT AREA 15,000 SF DESIGN FLOW 240 L.T.A.R. 0.25 GPD/FT

Septic Tank 1000	Gallons: STB JM 1060	Date N/A	☑ New System	☐ Repair	☐ Expansion System	Type I II III IV V VI	☑ Residence	No. Bedrooms 2	Water Supply
Pump Tank	Gallons: P T	Date	System Description:				☐ Business	No. Persons	☐ Private
Pump Make	Model	Serial #	Repair System Description: 50% REDUCTION GRAVITY				☐ Other	No. Employees	☑ Public
No. Nitrification Fields: 1	No. Lines 4	Linear Feet 160 (4x40)	Maintenance Agreement Required ☐ YES ☑ NO				☐ Slab	☑ Crawl Space	☐ Community
Trench Width 24"	Max. Trench Bottom Depth 36"	Trench Depth 24"	☑ GRAVITY	☐ PRESSURE			☐ Basement w/plumbing	☐ Basement w/o plumbing	

Comments / Conditions ① ABANDON EXISTING WELL PRIOR TO ISSUANCE of AUTHORIZATION TO CONSTRUCT (WELL ABANDONMENT PERMIT REQUIRED) ② INSTALL 36 PPBPS PANELS USING PARALLEL DISTRIBUTION

KEEP SYSTEM MINIMUM 5' FROM PROPERTY LINES.

INITIAL SITE SKETCH

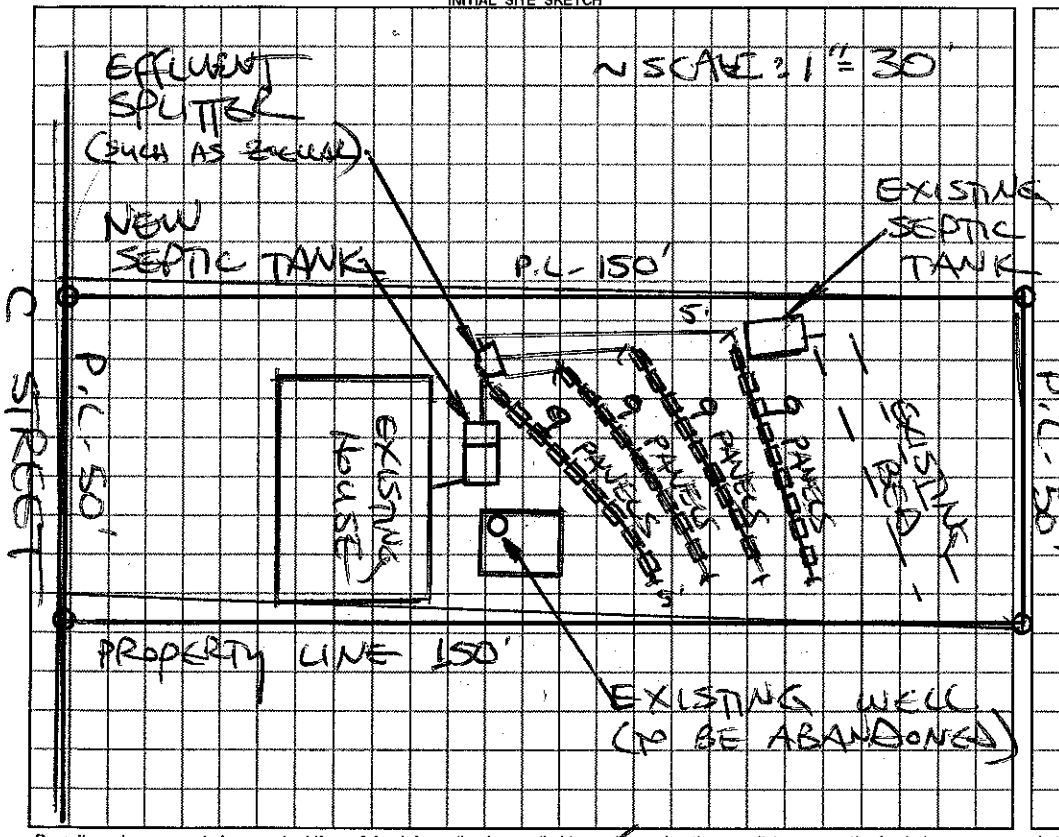

AS BUILT SKETCH

DRAINLINES INSPECTED 5/21/12

SYSTEM REPAIRED ACCORDING TO INITIAL SITE SKETCH

5/22/12

Permit can be suspended or revoked if any false information is supplied toward securing the permit / any unauthorized changes are made to the site / any unauthorized changes are made in the installation of the system.

☐ ***IMPROVEMENT PERMIT*** with plat valid without expiration. ☑ ***IMPROVEMENT PERMIT*** with plat valid without expiration. site plan valid 60 mo. ☐ ***AUTHORIZATION TO CONSTRUCT***, valid for period equal to IMPROVEMENT PERMIT--not to exceed 60 mo.

Owner / Applicant Signature: Robert Lofland (Robert Lofland) Date 5-9-12 Installed by: JAMES HYDER

IMPROVEMENT PERMIT by: STEVE HEDRICK REHS Date 5-8-2012 OPERATION PERMIT by: STEVE HEDRICK REHS Date 5/22/12

AUTHORIZATION TO CONSTRUCT by: STEVE HEDRICK REHS Date 5-10-2012 Existing System Inspected by: REHS Date

YOU SHOULD CONTACT A LOCATOR SERVICE PRIOR TO ANY EXCAVATION

White Copy – Environmental Health YELLOW COPY (Final) Owner / Applicant PINK COPY (Initial) Owner / Applicant