IREDELL COUNTY HEALTH DEPARTMENT

STATESVILLE 704-878-5305 MOORESVILLE 704-664-5281

IMPROVEMENT PERMIT / AUTHORIZATION TO CONSTRUCT / OPERATION PERMIT / EXISTING SYSTEM INSPECTION

PERMIT# REPAIR PIN# 4724-68-5313 DATE 4-7-04

OWNER OR CONTRACTOR STEVEN ARTHUR SWANN PHONE: Business 704-876-6498 Home

ADDRESS P.O. Box 57, SCOTTS, NC 28699-0057

LOCATION US 64 WEST TO BRISTOL DRIVE, HOUSE ON CORNER OF WESTMINSTER DRIVE

SUBDIVISION SHERRILL BLOCK / SECTION LOT 248-251 LOT AREA LIMITED SITE CLASS. PS DESIGN FLOW 240 L.T.A.R. EXISTING

Septic Tank: 1000 Gallons; STB 1007 Date 2-27-04
Pump Tank: Gallons; PT Date
Pump Make: Model Serial No.
Nitrification Field: No Fields 1 Square Feet Linear Feet EXISTING
No Lines EXISTING Trench Width Max Trench Bottom Depth Gravel Depth

☐ New System ☑ Repair System Type: I, II, III, IV, V, VI
System Description:
Repair System Description: CONVENTIONAL GRAVITY
Maintenance Agreement Required: ☐ Yes ☐ No

☐ House/Mod. Home No. Bedrooms 2
☐ Mobile Home No. Bathrooms 1
☐ Business No. Employees
☐ Other


☐ Slab ☑ Crawl Space ☐ Basement w/plumbing ☐ Basement wo/plumbing

Water Supply: ☐ Individual ☑ Public ☐ Community

Comments:/Conditions: REPLACE EXISTING SEPTIC TANK AS SHOWN

Comments:/Conditions: NEW SEPTIC TANK WITH MARKER INSTALLED USING "ZABTITE" FILTER

INITIAL SITE SKETCH

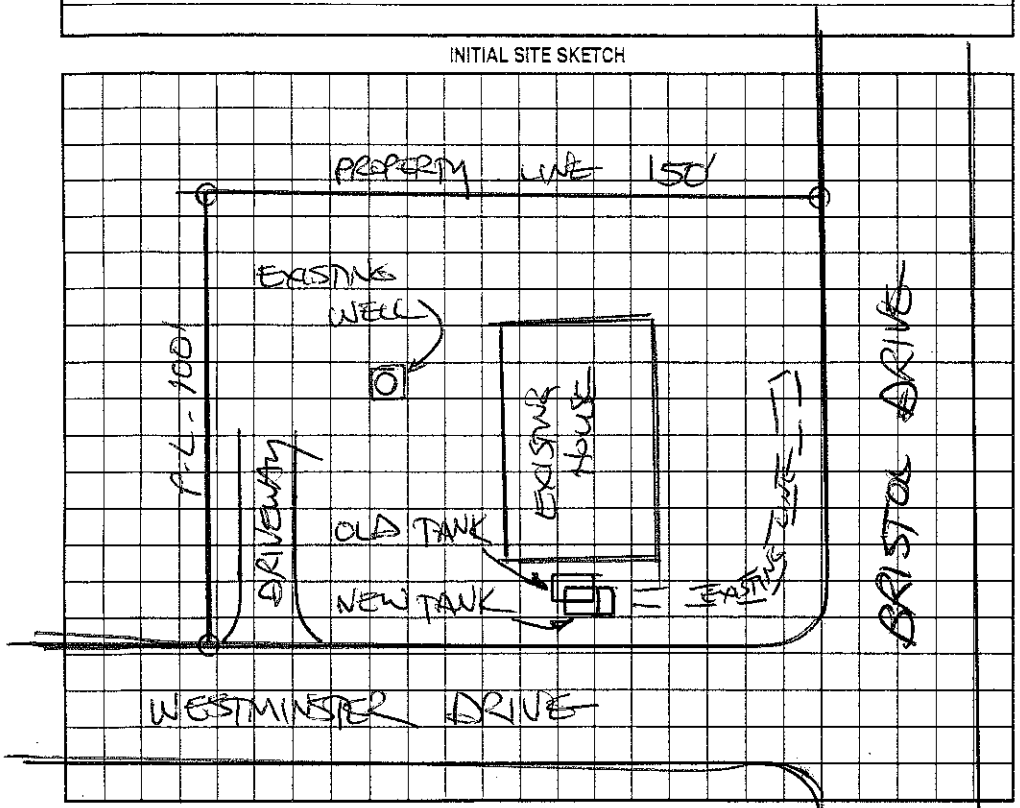

AS BUILT SKETCH

SYSTEM REPAIRED AS SHOWN

Permit can be suspended or revoked if any false information is supplied toward securing the permit/any unauthorized changes are made to the site/any unauthorized changes are made in the installation of the system. Improvement Permit with plat valid without expiration. Improvement Permit with site plan valid for sixty months. Authorization to Construct is valid for a period equal to that of Improvement Permit – not to exceed sixty months.

Signed: [signature] date 4-7-04 Installed by: JAMES FRAZIER

Improvement Permit by: STEVE HENDRICK date 4-7-04 Operation Permit by: STEVE HENDRICK date 4-7-04

Authorization to Construct by: STEVE HENDRICK date 4-7-04 Existing System Inspection by: date

HEALTH DEPT. COPY: WHITE OWNER COPY (FINAL): YELLOW OWNER COPY (INITIAL): PINK