IREDELL COUNTY HEALTH DEPARTMENT

Statesville Phone TR 3-7271 Mooresville Phone No. 664-5281

PERMIT TO INSTALL SEPTIC TANK

Permit No. 414 Permit Date 3-2 1973

Owner E. J. Webb Realty Co. Address Statesville N C

Installed By Henry Sigmon Address Statesville N.C.


Location of Property Corner of Hwy # 90 and Bristal Drive

Tank		Capacity		Length of Lines		Fixtures	
Block	( )	1000	( )	225'	( )	No. of Baths	( )
Precast	( )	1250	( )	250'	( )	Dishwasher	( )
		1500	( )	Other 100		Garbage Grdr.	( )
		Other				Other	

NOTIFY HEALTH DEPARTMENT AT LEAST EIGHT HOURS BEFORE TANK IS TO BE INSPECTED.

Final Inspection 3-2 1973 Approved (✓) Disapproved ( )

Remarks City Water

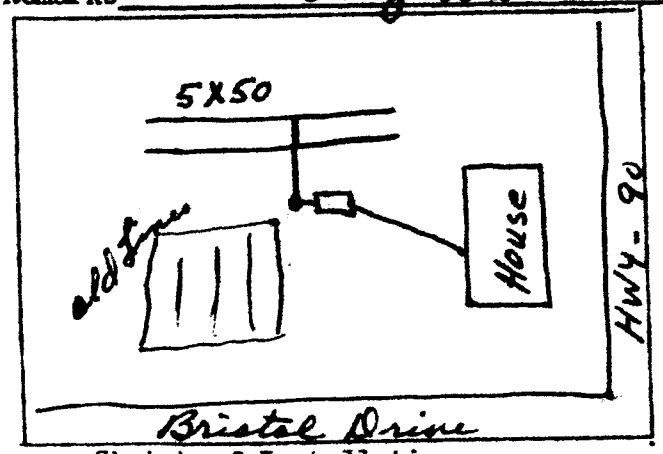

Sketch of Installation

100' additional line added. House will be torn down when new Hwy is completed.

-Repair-

E. G. Stevenson

Sanitarian