IREDELL COUNTY HEALTH DEPARTMENT

Statesville Phone TR 3-7271 Mooresville Phone NO 3-1271

PERMIT TO INSTALL SEPTIC TANK

Permit No. _____ Permit Date July 9 1965

Owner Bristol Grove Baptist Church Address Bristol Drive Statesville N. C.

Installed By S & D Address " " "


Location of Property _____

Tank		Capacity		Length of Lines		Fixtures	
Block	( )	1000	(✓)	225'	(✓)	No. of Baths	( )
Precast	( )	1250	( )	250'	( )	Dishwasher	( )
		1500	( )	Other _____		Garbage Grdr.	( )
		Other _____				Other _____	

NOTIFY HEALTH DEPARTMENT AT LEAST EIGHT HOURS BEFORE TANK IS TO BE INSPECTED.

Final Inspection July 9 1965 Approved ( ) Disapproved ( )

Remarks _____

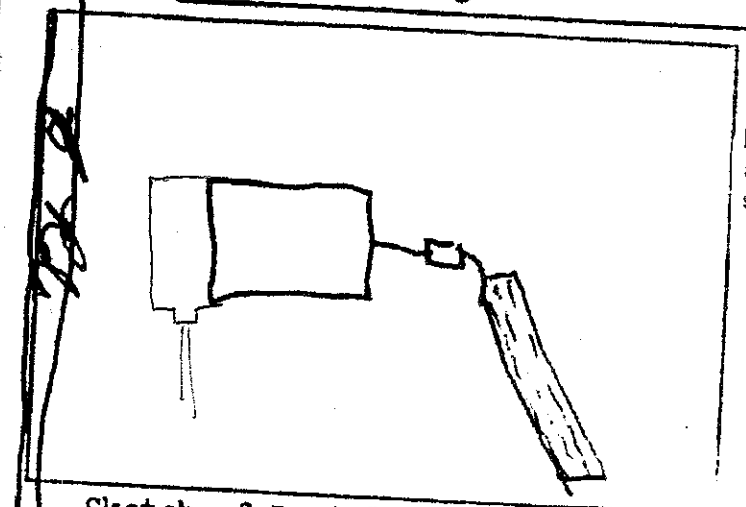

Sketch of Installation

Location of the proposed church addition - No fellowship / kitchen addition - No increase in sanctuary addition does not appear to impact the existing on-site septic system.**NOTE:

_____ REHS

Date: 4-20-12

ICHD-Environmental Health Division

Sanitarian