IREDELL COUNTY HEALTH DEPARTMENT

Statesville Phone TR 3-7271 Mooresville Phone NO 3-1271

PERMIT TO INSTALL SEPTIC TANK

Permit NO. _____ Permit Date 7-29 1966

Owner Mid State Oil Co. Address Statesville, NC

Installed By H. L. Hedrick Address Statesville, N.C.


Location of Property Hwy 90, Service Station on left across from Kappa Technical Furniture Co.

Tank		Capacity		Length of Lines		Fixtures	
Block	( )	1000	(✓)	225'	( )	No. of Baths	( )
Precast	( )	1250	( )	250'	( )	Dishwasher	( )
		1500	( )	Other _____		Garbage Grdr.	( )
		Other _____				Other _____	

NOTIFY HEALTH DEPARTMENT AT LEAST EIGHT HOURS BEFORE TANK IS TO BE INSPECTED.

Final Inspection 7-29 1966 Approved (✓) Disapproved ( )

Remarks Dry Water

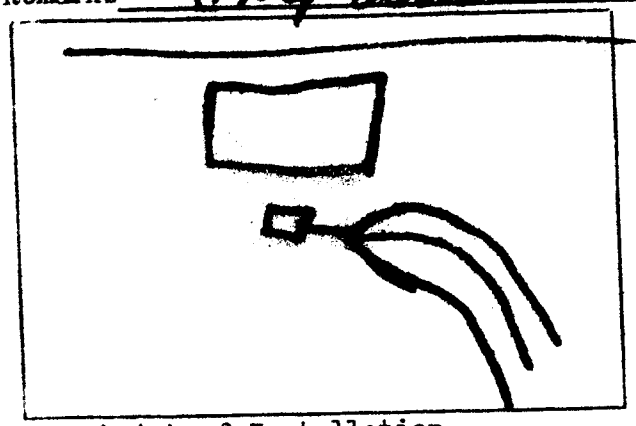

Sketch of Installation

Sanitarian