ICHD - ENVIRONMENTAL HEALTH DIVISION

Statesville Office (704) 878-5305 x3456 Mooresville Office (704) 660-3625

PERMIT ; OSWP 2025-736608

PIN # 4724-70-9976

SEPTIC: IMPROVEMENT PERMIT / AUTHORIZATION TO CONSTRUCT / OPERATION PERMIT / EXISTING SYSTEM

APPLICANT/OWNER: Jessicah Carlton APPLICANT ADDRESS: 1148 Rita Ave. Statesville NC 28677

SITE ADDRESS: 1148 Rita Ave. Statesville NC 28677 PHONE: 336 5166 6537 ALT. PHONE

SITE DIRECTIONS: W Front St → (L) Newton Dr → (L) Park Dr → (R) Williams Rd → Rita Ave. SAP CONTROLLED: ☐ YES ☐ NO

SUBDIVISION: Lincoln Estates SECTION: 1 LOT # 10 LOT AREA: 0.253 DESIGN FLOW: EXT L.T.A.R.(Initial): — L.T.A.R (Repair): —

Septic Tank 1000 (gal) STB 760 Date

Pump Tank (gal) PT Date

Pump Make Model Serial #

Nitrification Fields 1 # Lines 12 x 35 BED Linear Ft 420 sqft

Trench Width — *Max. Trench Depth(Initial) — *Max. Trench Depth(Repair) Gravel Depth —

* Measured on the downhill side of the trench

☐ New System ☒ Repair ☐ Expansion System Type: I (II) III IV V VI

System Description: EXISTING BED

Repair System Description: TANK REPLACEMENT

Maintenance Agreement Required: ☐ YES ☒ NO

☒ GRAVITY ☐ PRESSURE

Effluent Standard: ☒ DSE ☐ HSE ☐ TS-I ☐ TS-II ☐ RCW ☐ NSF/ANSI 40

Usable Depth to LC (Initial): —

☐ Residence ☐ Business ☐ Other ☐ Slab ☐ Basement w/plumbing

No. Bedrooms EXT No. Persons — No. Employees — ☒ Crawl Space ☐ Basement w/o plumbing


Usable Depth to LC (Repair): — *Limiting Condition*

Water Supply: ☐ Private ☒ Public ☐ Community

Comments / Conditions: Pump, crush, fill existing tank Replace distribution as needed. System functional at time of inspection.

INITIAL SITE SKETCH

SCALE 1" = 40'

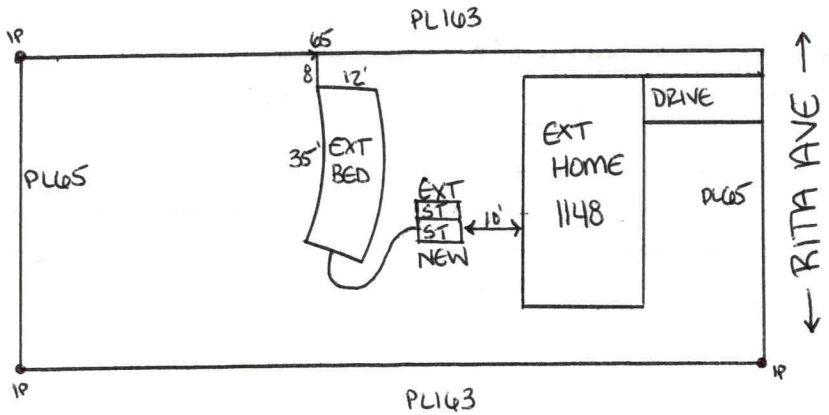

AS BUILT SKETCH

FOR SEPTIC FINAL INSPECTION CALL: 704-664-3703 between 8am-9am the day the inspection is needed. Be sure to speak with an inspector to confirm your time.

Installed as Drawn

Permit can be suspended or revoked if any false information is supplied toward securing the permit / any unauthorized changes are made to the site / any unauthorized changes are made in the installation of the system. **CONTACT A LOCATOR SERVICE PRIOR TO ANY EXCAVATION**

☐ **IMPROVEMENT PERMIT** *with plat valid without expiration.* ☒ **IMPROVEMENT PERMIT** *with site plan valid for 60 mos.* ☒ **AUTHORIZATION TO CONSTRUCT** *valid for period equal to IMPROVEMENT PERMIT--not to exceed 60 mo.*


Owner / Applicant Signature: ONLINE Date: — Installed by: Lentz

IMPROVEMENT PERMIT by: Sarah Williams Date: 4/17/2025 OPERATION PERMIT by: Cory Hill Date: 5/2/25

AUTHORIZATION TO CONSTRUCT by: Sarah Williams Date: 4/17/2025 Existing System Inspected by: Date:

Item	Date	Initials
Drain Lines Checked		
Tanks Checked		
Pressure Manifold or Valve Box Checked		
Pressure Head Set		
Electrical Checked		
Floats Set		
Alarm Checked		
Maintenance Contract Needed? Y / N		
Comments:		

Repairs Only	
	State Code
Failing System Code	
Type of Distribution	G or P
Type of Failure/Malfunction	
Primary Cause of Failure/Malfunction	
Age of System? _____	
Initial or Repair? _____	

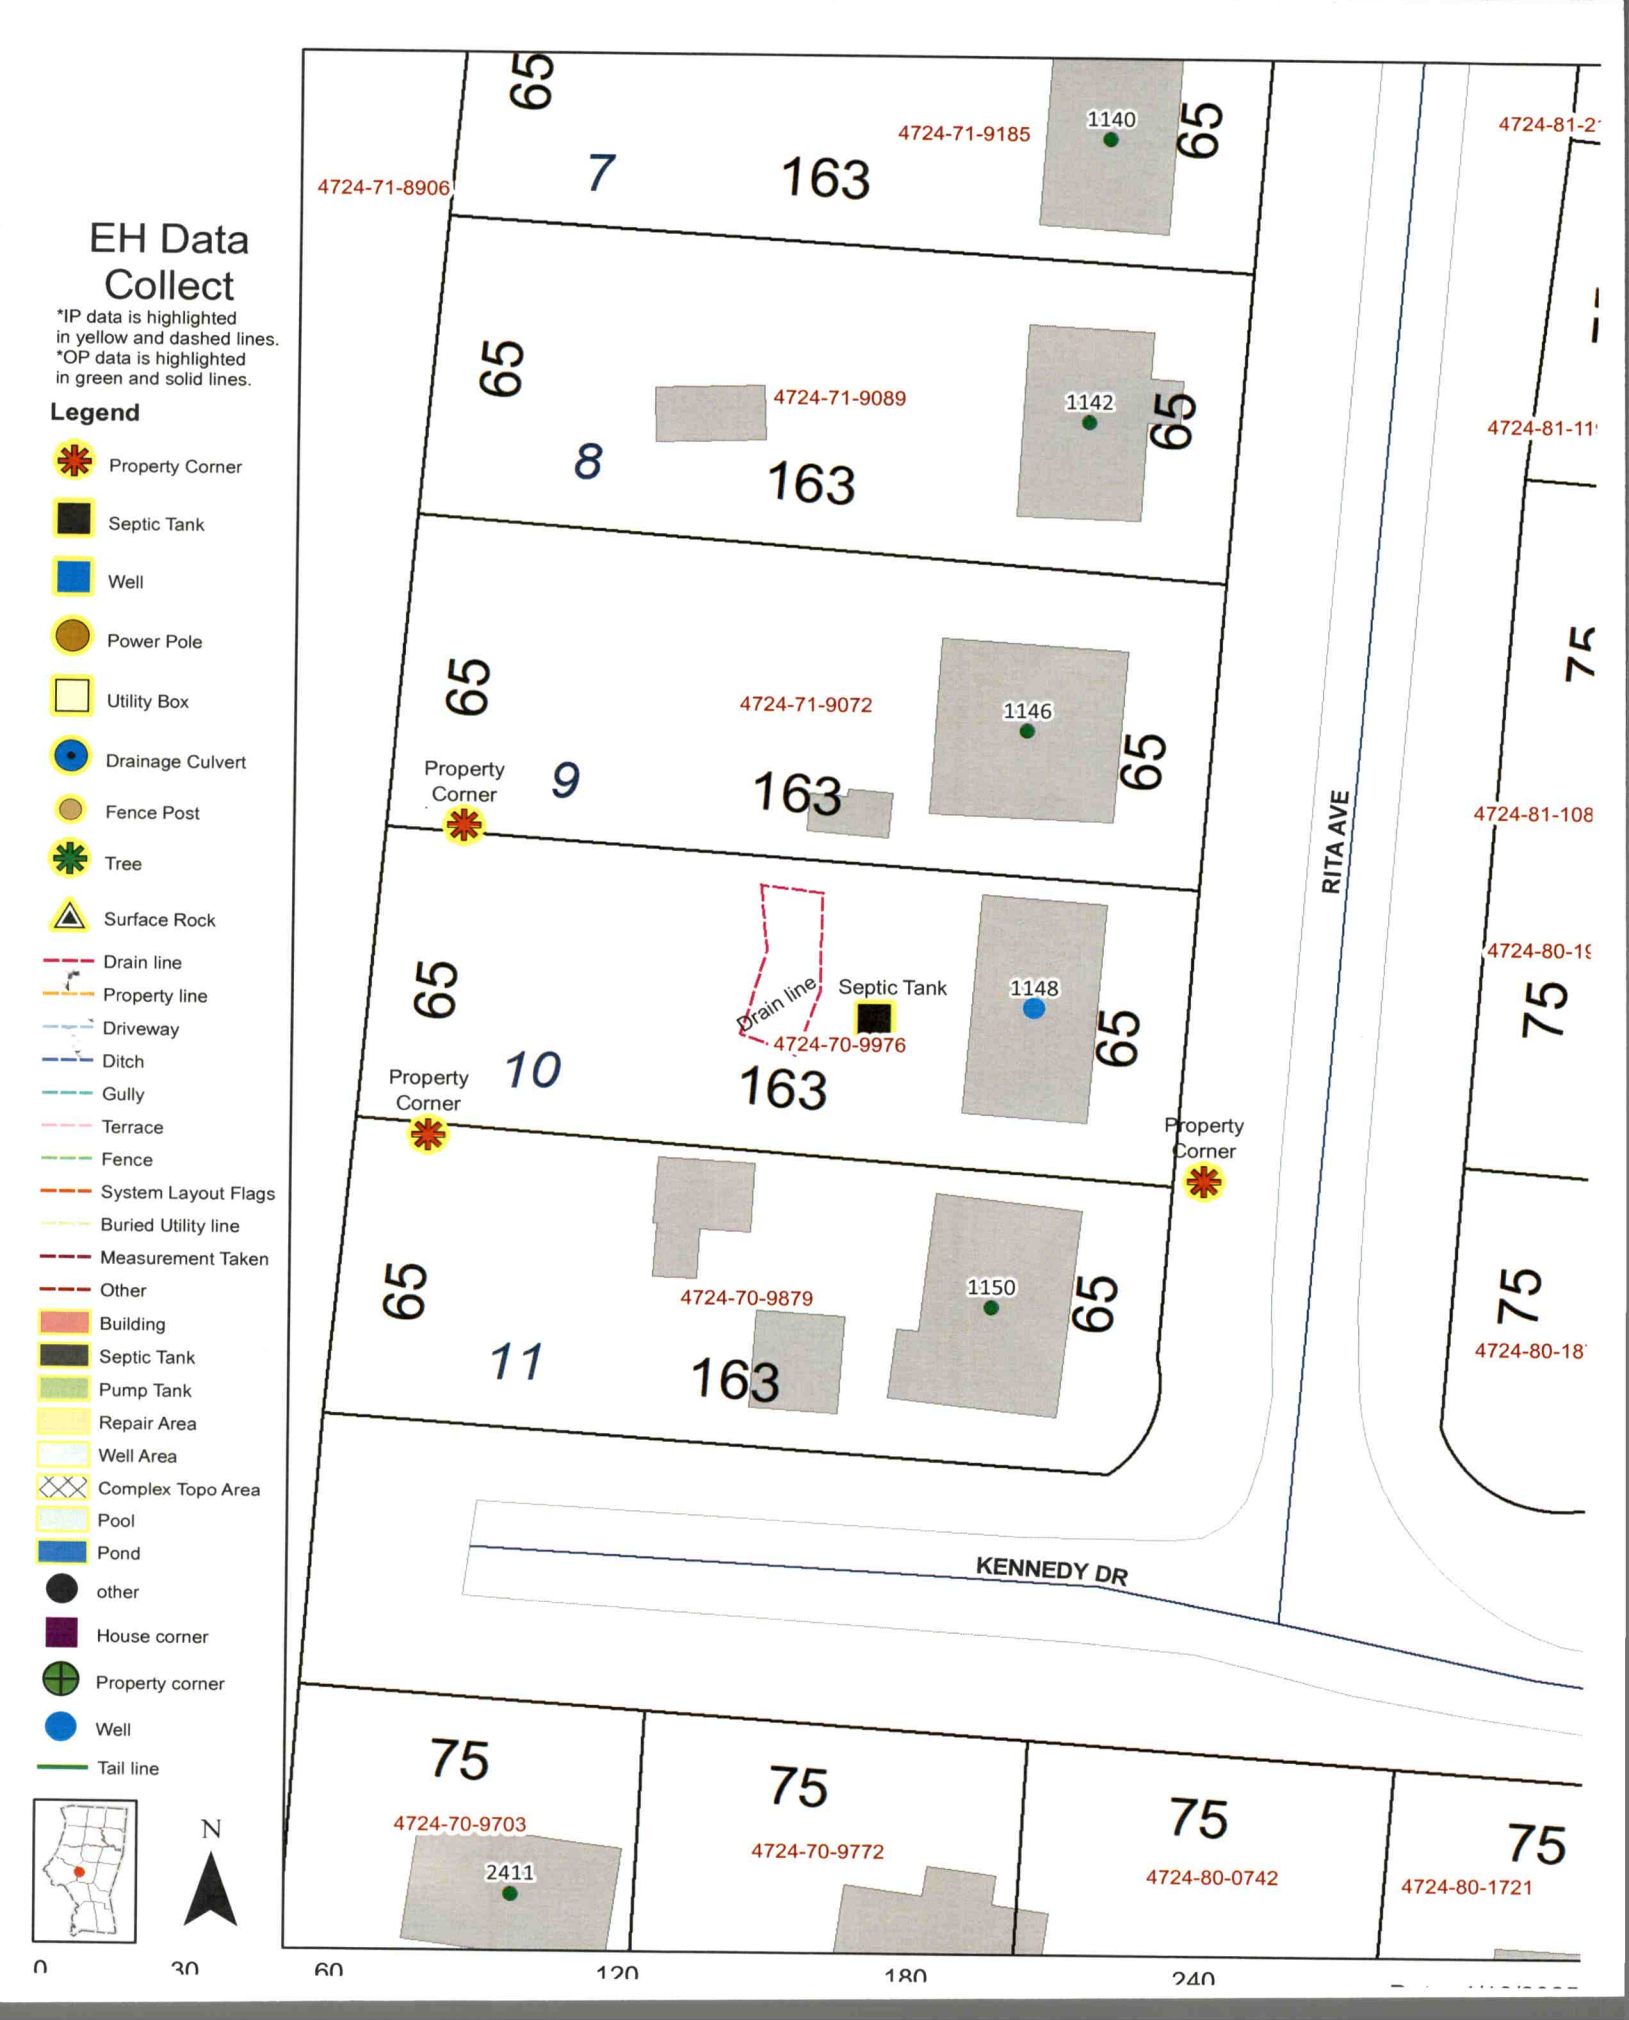
EH Data Collect
*IP data is highlighted in yellow and dashed lines.
*OP data is highlighted in green and solid lines.
Legend
Property Corner
Septic Tank
Well
Power Pole
Utility Box
Drainage Culvert
Fence Post
Tree
Surface Rock
Drain line
Property line
Driveway
Ditch
Gully
Terrace
Fence
System Layout Flags
Buried Utility line
Measurement Taken
Other
Building
Septic Tank
Pump Tank
Repair Area
Well Area
Complex Topo Area
Pool
Pond
other
House corner
Property corner
Well
Tail line
N
0
30
60
120
180
240
4724-71-8906
4724-71-9185
1140
4724-71-9089
1142
4724-71-9072
1146
Property Corner
Drain line
Septic Tank
4724-70-9976
1148
Property Corner
Property Corner
4724-70-9879
1150
4724-70-9703
2411
4724-70-9772
4724-80-0742
4724-80-1721
4724-81-2
4724-81-11
4724-81-108
4724-80-19
4724-80-18
RITA AVE
KENNEDY DR
7
8
9
10
11
163
65
75

PERMIT SNAPSHOT REPORT OSWP-2025-73668 FOR IREDELL COUNTY

Permit Type	Environmental Health OSWP	**Project:**		**App Date:**	04/08/2025
Work Class:	EH Septic Permit	**District:**	Statesville	**Exp Date:**	NOT AVAILABLE
Status:	PRIORITY PERMIT	**Square Feet:**	0.00	**Completed:**	NOT COMPLETED
Valuation:	$0.00	**Assigned To:**	Williams, Sarah	**Approval Expire Date:**	

Description: PRIORITY PERMIT -- REPAIR Need to repair existing tank
- Pump, crush and fill existing septic tank
- Install 1000 gallon septic tank with filter and risers
- Install new 4"Sch 40 PVC 2-way clean out and new 4" Sch 40 PVC supply line from house to tank
- Excavate distribution device/s to assess condition and replace, if needed.
- Make all necessary connections to existing drain field
- Environmental Health Department on site for approval, prior to covering

Parcel: 4724709976.000 Main	**Address:** 1148 Rita Ave Statesville, NC 28677 Main	**Zone:** R-5M(High Density Single-Family/Manufa

Property Owner
Dillon Carlton
Mobile: (336) 566-8185

Applicant/Authorized Agent
Jessicah E Carlton
1148 Rita Avenue
Statesville, NC 28677
Mobile: (336) 566-6537

Permit Custom Fields

How is your site plan being submitted	Survey Plat	Septic Application/Permit Type	Repair	Does the site contain any jurisdictional wetlands	No
Non-domestic Sewage Generated	No	Other Public Agency	No	All proposed structure dimensions	New septic tank
What are the proposed structures	Other Addition/Structure	Maximum Number of Bedrooms	3	If other Addition/Structure, please explain	
Number of Occupants	2	Foundation Type	Crawl Space Foundation	Water Supply	Municipal Water
Desired Septic System Type	Conventional (most common)	If other septic system type, please explain		Additional Unique Setbacks Apply	No

Attachment File Name	Added On	Added By	Attachment Group	Notes
Signature_Jessicah_Carlton_4/8/2025.jpg	04/08/2025 2:11	Carlton, Jessicah		Uploaded via CSS
DOC TO AUTHORIZE AN OWNER_1_v1.pdf	04/08/2025 8:49	Carlton, Jessicah	Available Online	
lentzwastewatermanagement_1148rita ave_v1.pdf	04/08/2025 8:49	Carlton, Jessicah	Available Online	
plan_v1.pdf	04/08/2025 8:49	Carlton, Jessicah	Available Online	

Workflow Step / Action Name	Action Type	Start Date	End Date
Application Completeness Check v.1		04/08/2025 8:49	04/08/2025 8:49
Confirm application complete v.1	Generic Action		04/08/2025 8:49
~~**Zoning Review v.1**~~			04/08/2025 8:49
~~Floodplain Admin Overview v.1~~	Task		04/08/2025 8:49
~~Statesville Zoning Approval v.1~~	Task		04/08/2025 8:49
~~Issue Invoice v.1~~	Generic Action		04/08/2025 8:49
~~Fees Paid v.1~~	Generic Action		04/08/2025 8:49
Fees v.1			
Issue Invoice v.1	Generic Action		

PERMIT SNAPSHOT REPORT (OSWP-2025-73668)

Fees Paid v.1	Generic Action	
Lot Readiness Verification v.1		
~~OSWP Septic Preliminary Site Visit v.1~~	Inspection	04/08/2025 8:49
OSWP Site Evaluation v.1	Inspection	
Issue Improvement Permit v.1		
Issue Invoice v.1	Generic Action	
Fees Paid v.1	Generic Action	
Issue Permit v.1	Generic Action	
Permit Completion Process v.1		
Authorization to Construct Permit v.1	Create Sub Permit	
Issue Authorization to Construct v.1	Generic Action	