IREDELL COUNTY HEALTH DEPARTMENT

STATESVILLE 704-878-5305 MOORESVILLE 704-664-5281

IMPROVEMENT PERMIT / CERTIFICATE OF COMPLETION / OPERATION PERMIT / EXISTING SYSTEM INSPECTION

PROPERTY DESCRIPTION NO. _____ DATE 5-21-97 TAX MAP NO. _____

OWNER OR CONTRACTOR Lory Hairston PHONE: Business _____ Home 877-6167 Watershed: ☐ Yes ☑ No

ADDRESS 1140 Rita Ave

LOCATION 70W TL Park TR William TL Rita on Rt.

SUBDIVISION _____ BLOCK / SECTION _____ LOT _____ LOT AREA _____ SITE CLASS. _____ DESIGN FLOW _____ L.T.A.R. _____

Septic Tank: EX. Gallons; STB 1012 Date 8-11-97

Pump Tank: _____ Gallons; PT _____ Date _____

Pump Make: _____ Model _____ Serial No. _____

Nitrification Field: No Fields 1 Square Feet 1720 Linear Feet 240

No Lines 6 Trench Width 72" Max Trench Bottom Depth 36" Gravel Depth 18"

☐ New System ☐ Repair System Type: I, II, III, IV, V, VI

System Description: _____

Repair System Description: _____

Maintenance Agreement Required: ☐ Yes ☐ No

☐ House/Mod. Home No. Bedrooms 3

☐ Mobile Home No. Bathrooms 1½

☐ Business No. Employees ____

☐ Other _____


☐ Slab ☑ Crawl Space ☐ Basement w/plumbing ☐ Basement wo/plumbing

Water Supply: ☐ Individual ☐ Community ☑ Public


Comments: Replace lids & Tee For Septic tank if necessary

Comments:

INITIAL SITE SKETCH

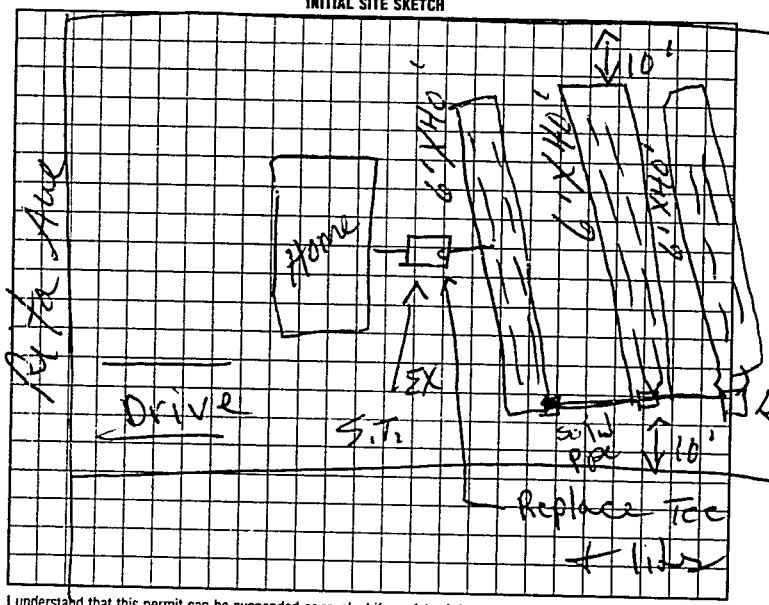

AS BUILT SKETCH

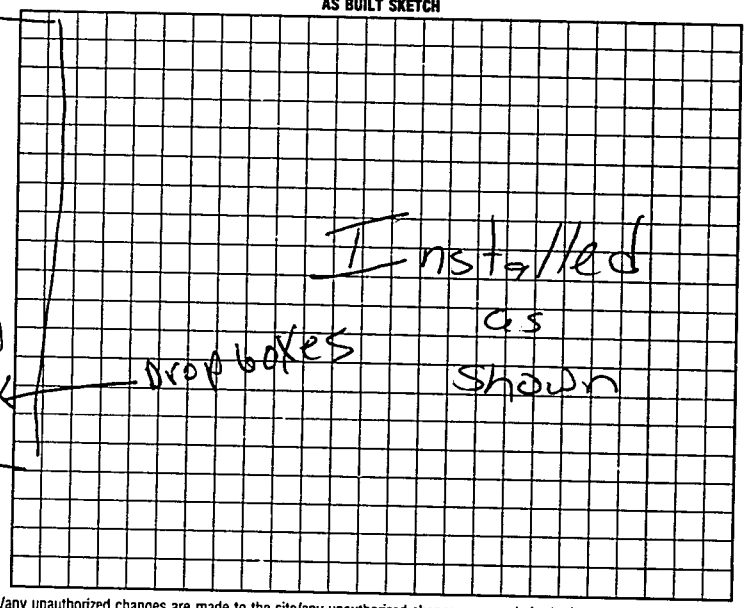

I understand that this permit can be suspended or revoked if any false information is supplied toward securing the permit/any unauthorized changes are made to the site/any unauthorized changes are made in the installation of the system. Improvement Permit is valid for 60 months from date of issuance.

Signed: Lory Hairston

Improvement Permit by: L.C. Moore date 5-21-97

~~Existing System Inspection by:~~ L.C. Moore date 5-21-97

Installed by: Benny Sigmon

Certificate of Completion by: _____ date _____

Operation Permit by: Mary C. Owens date 9-26-97

HEALTH DEPT. COPY: WHITE INSPECTION COPY (FINAL): GREEN OWNER COPY (FINAL): YELLOW INSPECTION COPY (INITIAL): PINK OWNER COPY (INITIAL): BLUE

to County. Authorization to count expires 60 days from issue