IREDELL COUNTY HEALTH DEPARTMENT

STATESVILLE 704-878-5305 MOORESVILLE 704-664-5281

Repair

IMPROVEMENT PERMIT / AUTHORIZATION TO CONSTRUCT / OPERATION PERMIT / EXISTING SYSTEM INSPECTION

PERMIT# _____ PIN# _____ DATE Feb 9 2000

OWNER OR CONTRACTOR Ella Sides PHONE: Business _____ Home 872 2801

ADDRESS 921 Candy Dr

LOCATION Hwy 70 W (L) Candy ~~Lane~~ Drive Follow To end home on Lft Last house

SUBDIVISION _____ BLOCK / SECTION _____ LOT _____ LOT AREA _____ SITE CLASS. _____ DESIGN FLOW _____ L.T.A.R. _____

Septic Tank: _____ Gallons; STB _____ Date _____
Pump Tank: _____ Gallons; PT _____ Date _____
Pump Make: _____ Model _____ Serial No. _____
Nitrification Field: No Fields ____ Square Feet _____ Linear Feet _____
No Lines _____ Trench Width _____ Max Trench Bottom Depth _____ Gravel Depth _____

☐ New System ☒ Repair System Type: I, II, III, IV, V, VI
System Description: _____
Repair System Description: _____
Maintenance Agreement Required: ☐ Yes ☒ No

☒ House/Mod. Home No. Bedrooms 3
☐ Mobile Home No. Bathrooms ____
☐ Business No. Employees ____
☐ Other _____

☐ Slab ☐ Crawl Space ☒ Basement w/plumbing ☐ Basement wo/plumbing


Water Supply:
☒ Individual
☐ Public
☐ Community

Comments:/Conditions: Slow draining & Backing up in basement floor drain
Stone in Bed system is dry
Call 928-2030 If Any Questions

INITIAL SITE SKETCH

Comments:/Conditions No Sign of System Surfacing.
1. Uncover outlet end of Tank & Replace Baffel if Needed
2. Replace Supply Line to Septic Field
3. Install New Distribution box if Needed.

AS BUILT SKETCH

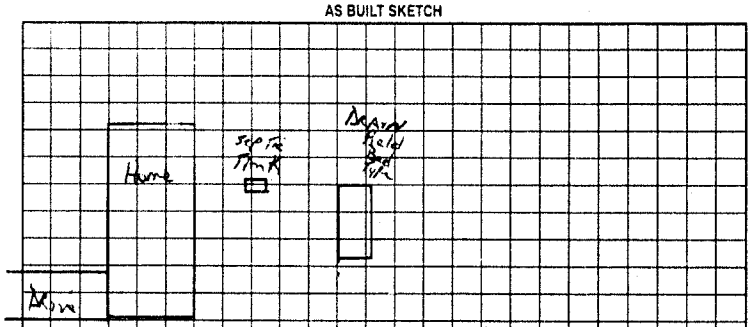

Feb 11, 2000 Tank Pumped New Sanitary Tee installed
Roots unclogged from inlet end
New D-Box installed and Tied into old old supply line
2 ft section of supply line replaced w/ Blue Pipe
Tapped Cotta Supply Line Roots Rooted out

Permit can be suspended or revoked if any false information is supplied toward securing the permit/any unauthorized changes are made to the site/any unauthorized changes are made in the installation of the system. Improvement Permit with plat valid without expiration. Improvement Permit with site plan valid for sixty months. Authorization to Construct is valid for a period equal to that of Improvement Permit – not to exceed sixty months.

Signed: Ella Sides date: 2/11/2000 Installed by: Wes Cotton

Improvement Permit by: Jc Potter date Feb 9 2000 Operation Permit by: Jc Potter date Feb 11, 2000

Authorization to Construct by: Jc Potter date Feb 9 2000 Existing System Inspection by: _____ date _____

HEALTH DEPT. COPY: WHITE OWNER COPY (FINAL): YELLOW OWNER COPY (INITIAL): PINK