IREDELL COUNTY HEALTH DEPARTMENT

Statesville Phone TR 3-7271 Mooresville Phone MO 3-1271

PERMIT TO INSTALL SEPTIC TANK

Permit NO. _____ Permit Date July 30 1963

Owner Smith Homes Address Statesville

Installed By Roy Lentz Address Statesville


Location of Property Last Rd on Left before Carlins Barn Third House on Left

| Tank | Capacity | Length of Lines | Fixtures |
|---|---|---|---|
| Block ( ) | 800 ( ) | 150' ( ) | No. of Baths ( 1 ) |
| Precast ( ) | 900 ( ) | 175' ( ) | Dishwasher ( ) |
| Pound | 1000 ( 4 ) | 200' ( ) | Garbage Grdr. ( ) |
| | 1100 ( ) | 225' ( 4 ) | Auto-Washer ( 4 ) |
| | 1200 ( ) | 250' ( ) | Other _____ |
| | Other _____ | Other _____ | |

NOTIFY HEALTH DEPARTMENT AT LEAST EIGHT HOURS BEFORE TANK IS TO BE INSPECTED.

Final Inspection 7-30 1963 Approved ( 4 ) Disapproved ( )

Remarks _____

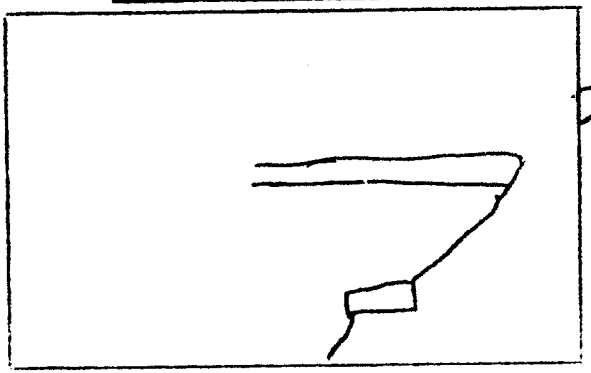


Sketch of Installation

Rat

Sanitarian