IREDELL COUNTY HEALTH DEPARTMENT

Statesville Phone TR 3-7271 Mooresville Phone NO 3-1271

PERMIT TO INSTALL SEPTIC TANK

Permit NO. _____ Permit Date May 15 1963

Owner Hoyt Hayes Address Statesville

Installed By Ray Lentz Address Statesville


Location of Property East Rd. on left before entering Mrs. Second House on left

| Tank | | Capacity | | Length of Lines | | Fixtures | |
|---|---|---|---|---|---|---|---|
| Block | ( ) | 800 | ( ) | 150' | ( ) | No. of Baths | (1) |
| Precast | ( ) | 900 | ( ) | 175' | ( ) | Dishwasher | ( ) |
| Rock | | 1000 | (✓) | 200' | ( ) | Garbage Grdr. | ( ) |
| | | 1100 | ( ) | 225' | (✓) | Auto-Washer | (✓) |
| | | 1200 | ( ) | 250' | ( ) | Other | |
| | | Other | | Other | | | |

NOTIFY HEALTH DEPARTMENT AT LEAST EIGHT HOURS BEFORE TANK IS TO BE INSPECTED.

Final Inspection 5-15 1963 Approved (✓) Disapproved ( )

Remarks

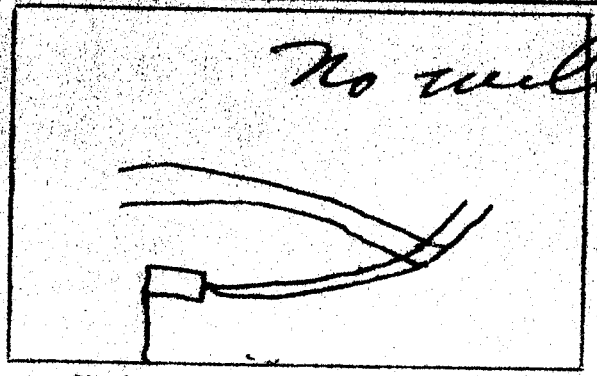


Sketch of Installation

Rot

Sanitarian