IREDELL COUNTY HEALTH DEPARTMENT

Statesville Phone TR 3-7271 Mooresville Phone NO 3-1271

PERMIT TO INSTALL SEPTIC TANK

Permit NO. _____ Permit Date May 21 1963

Owner Duffth Young Address Statesville

Installed By Ray Young Address Statesville


Location of Property Lot #2 on left before entering Fourth House on Left

Tank	Capacity	Length of Lines	Fixtures
Block ( )	800 ( )	150' ( )	No. of Baths (1)
Precast ( )	900 ( )	175' ( )	Dishwasher ( )
Poured	1000 (✓)	200' ( )	Garbage Grdr. ( )
	1100 ( )	225' (✓)	Auto-Washer (✓)
	1200 ( )	250' ( )	Other _____
	Other _____	Other _____	

NOTIFY HEALTH DEPARTMENT AT LEAST EIGHT HOURS BEFORE TANK IS TO BE INSPECTED.

Final Inspection 5-21-63 Approved (✓) Disapproved ( )

Remarks 160 ft

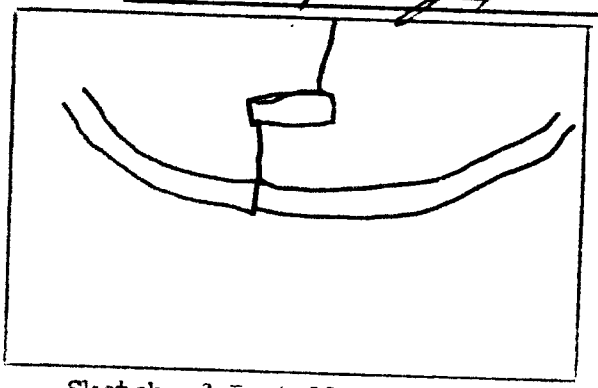

Sketch of Installation

R.L.

Sanitarian