IREDELL COUNTY HEALTH DEPARTMENT

Statesville Phone TR 3-7271 Mooresville Phone NO 3-1271

PERMIT TO INSTALL SEPTIC TANK

Permit No. _____ Permit Date Sept 27 1962

Owner Edmiston & Brinkley Bldrs Address City

Installed By C Hite Address R 7


Location of Property Sandy Dr. W. Statesville off 64-70 W - before Carolina Dr.

Tank		Capacity		Length of Lines		Fixtures	
Block	( )	1000	( )	225'	( )	No. of Baths	(2)
Precast	(✓)	1250	( )	250'	( )	Dishwasher	( )
		1500	( )	Other _____		Garbage Grdr.	( )
		Other _____				Other _____	

NOTIFY HEALTH DEPARTMENT AT LEAST EIGHT HOURS BEFORE TANK IS TO BE INSPECTED.

Final Inspection _____ 19___ Approved ( ) Disapproved ( )

Remarks well 55'

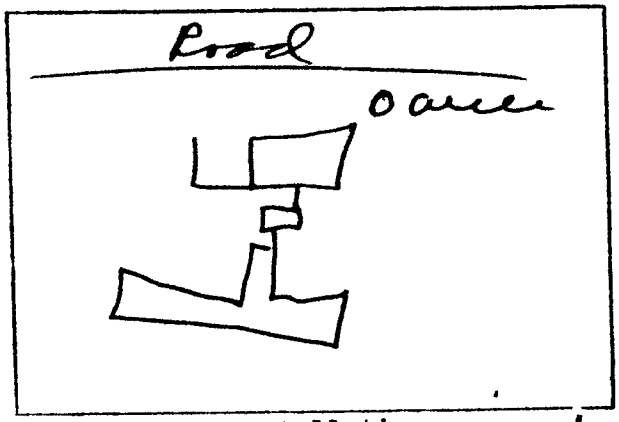

Sketch of Installation

Sanitarian