IREDELL COUNTY HEALTH DEPARTMENT

*This repair voids old permit 9-24-97

STATESVILLE 704-878-5305 MOORESVILLE 704-664-5281

IMPROVEMENT PERMIT / AUTHORIZATION TO CONSTRUCT / OPERATION PERMIT / EXISTING SYSTEM INSPECTION

PERMIT# REPAIR PIN# 4724-73-~~3811~~ 2689 DATE 4-8-04

OWNER OR CONTRACTOR Charles Ferguson PHONE: Business _____ Home (704) 873-9638

ADDRESS 2604 Newton Dr. Statesville, NC 28677

LOCATION US 70 W at corner of Newton and Central Dr.

SUBDIVISION (Newton Dr) CAMDILL BLOCK / SECTION _____ LOT 1 LOT AREA _____ SITE CLASS. PS DESIGN FLOW 360 L.T.A.R. EXISTING

Septic Tank: EXISTING Gallons; STB _____ Date _____
Pump Tank: _____ Gallons; PT _____ Date _____
Pump Make: _____ Model _____ Serial No. 1270
Nitrification Field: No Fields 1 Square Feet 1200 Linear Feet ~~200~~ 300
No Lines 4 Trench Width 36" Max Trench Bottom Depth 24"

☐ New System ☑ Repair System Type: I, (II), III, IV, V, VI
System Description: _____
Repair System Description: Conventional Gravity
Maintenance Agreement Required: ☐ Yes ☑ No
Gravel Depth 12"
☐ Slab ☑ Crawl Space ☐ Basement w/plumbing ☐ Basement wo/plumbing


☑ House/Mod. Home No. Bedrooms 3
☐ Mobile Home No. Bathrooms 2
☐ Business No. Employees _____
☐ Other _____

Water Supply: ☑ Individual ☐ Public ☐ Community


Comments:/Conditions: (1) Install lines 24" on contour (2) Install new d-box w/ speed levelers (3) Disconnect existing malfunctioning line (4) May have to remove large magnolia tree at ⊙ corner of house ~~(5)~~ Permit serves as NOV giving 30-days

Comments:/Conditions: (1) #5 Stone (2) Label Litter (3) Magnolia tree left in front yard, but suggested removal (4) Tank pumped out 6-24-04 (5) OH lines disconnected

Scale 1"=50' INITIAL SITE SKETCH to complete as of 4-8-04 ~~X~~

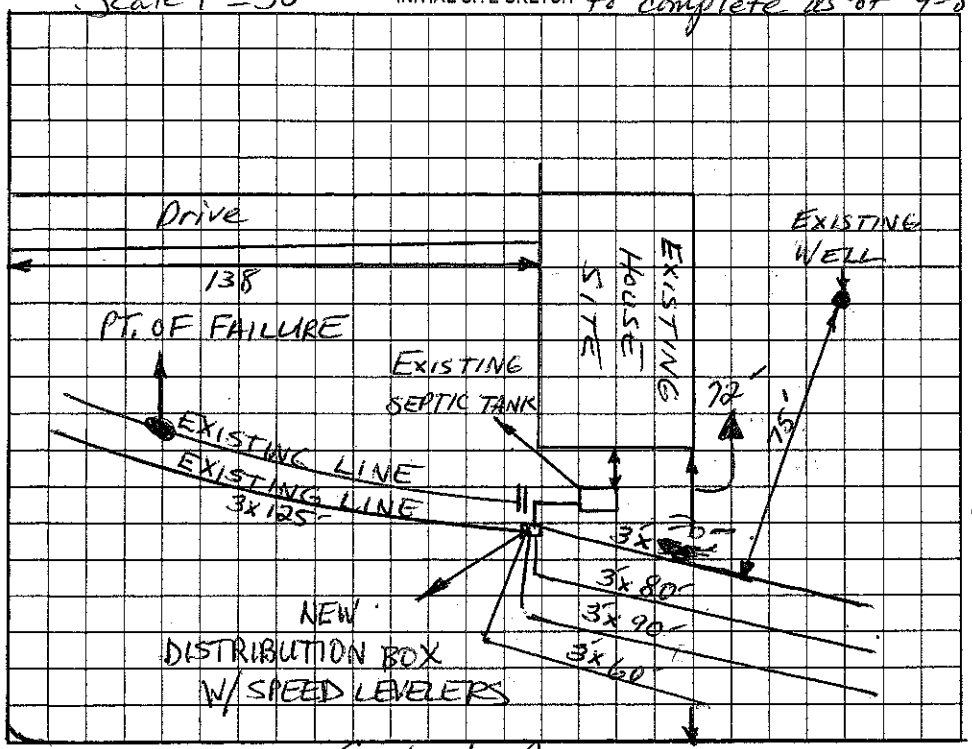

Scale 1"= 50' AS BUILT SKETCH

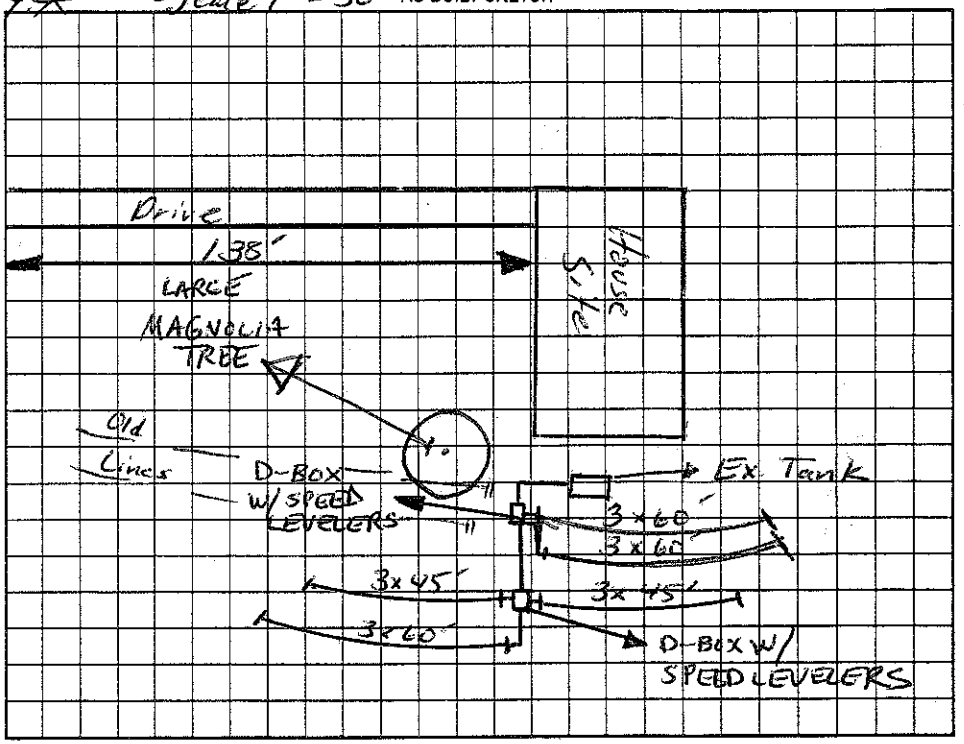

Permit can be suspended or revoked if any false information is supplied toward securing the permit/any unauthorized changes are made to the site/any unauthorized changes are made in the installation of the system. Improvement Permit with plat valid without expiration. Improvement Permit with site plan valid for sixty months. Authorization to Construct is valid for a period equal to that of Improvement Permit – not to exceed sixty months.

Signed: Charles J. Ferguson date 4-16-2004 Installed by: Charles Bryce

Improvement Permit by: Christopher M. Shell, RS date 4-8-04 Operation Permit by Christopher M. Shell, RS date 6-24-04

Authorization to Construct by: Christopher M. Shell, RS date 4-8-04 Existing System Inspection by: _____ date _____

HEALTH DEPT. COPY: WHITE OWNER COPY (FINAL): YELLOW OWNER COPY (INITIAL): PINK