Repair

IREDELL COUNTY HEALTH DEPARTMENT STATESVILLE 704-878-5305 MOORESVILLE 704-664-5281

IMPROVEMENT PERMIT / AUTHORIZATION TO CONSTRUCT / OPERATION PERMIT / EXISTING SYSTEM INSPECTION

PERMIT # Repair PIN # 4724-73-4686 DATE 2 June 09

OWNER or APPLICANT Willie Martin PHONE: Business (704) 873-9813 Home:

OWNER or APPLICANT ADDRESS 735 Central Drive Statesville.

LOCATION / DIRECTIONS Hwy 70W from Statesville. TR Central Drive - First on Rt. No Corner.

SUBDIVISION BLOCK / SECTION LOT # LOT AREA 1.04Ac± DESIGN FLOW 240 gpd L.T.A.R. 0.3 gpd/ft²

Septic Tank Exist. Gallons: STB Date

Pump Tank Gallons: P T Date

Pump Make Model Serial #

Nitrification Field No Fields 1 No Lines 3 Linear Feet 200

Trench Width 36" Max. Trench Bottom Depth 36" Gravel Depth

☐ New System ☑ Repair ☐ Expansion System Type I II III IV V VI

System Description: 25% Reduction

Repair System Description:

Maintenance Agreement Required ☐ YES ☑ NO

☑ GRAVITY ☐ PRESSURE

☑ Residence No. Bedrooms 2

☐ Business No. Persons

☐ Other No. Employees

☐ Slab ☑ Crawl Space

☐ Basement w/plumbing ☐ Basement w/o plumbing

Water Supply ☑ Private ☐ Public ☐ Community

Comments / Conditions

+ Keep 50'+ from existing wells located in storage building. / Replace tee in tank.

Comments / Conditions

INITIAL SITE SKETCH

Please see Attached Site Sketch.

AS BUILT SKETCH

Permit can be suspended or revoked if any false information is supplied toward securing the permit / any unauthorized changes are made to the site / any unauthorized changes are made in the installation of the system.

☐ *IMPROVEMENT PERMIT w / plat valid without expiration.* ☐ *IMPROVEMENT PERMIT w / site plan valid for 60 mos.* ☑ *AUTHORIZATION TO CONSTRUCT valid for period equal to IMPROVEMENT PERMIT-not to exceed 60 mo.*

Owner / Applicant Signature: Willie Martin Date 6-2-09

Improvement Permit by: Date

Authorization to Construct by: R.S. Date 2 June 09

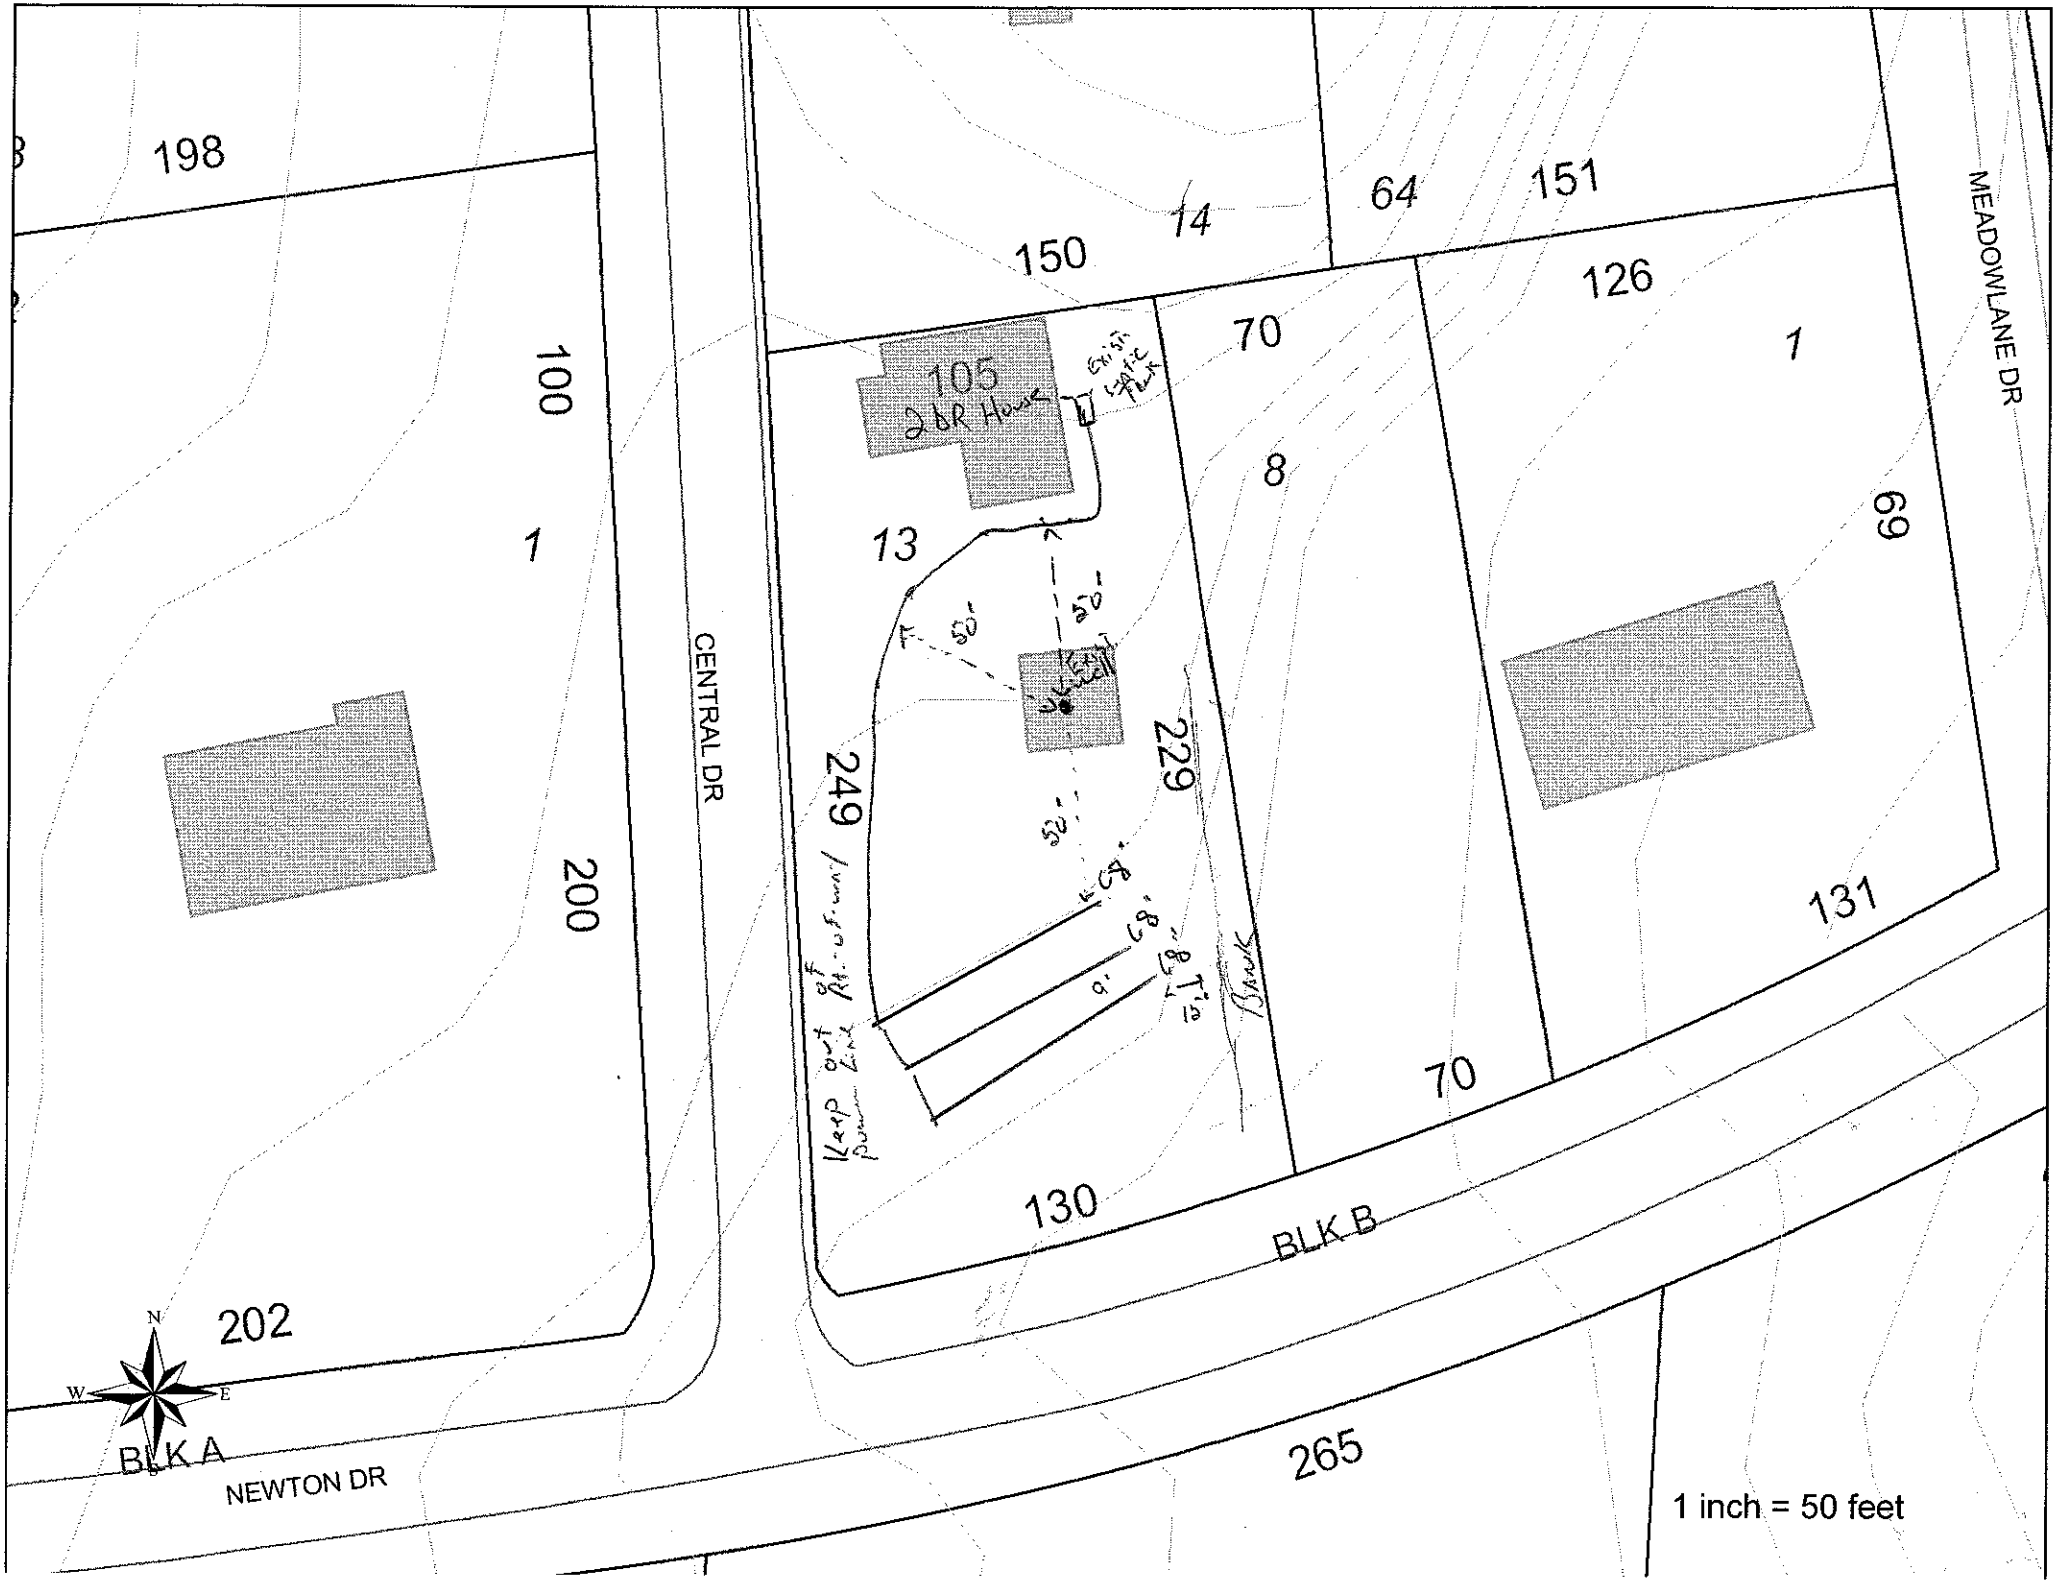
YOU SHOULD CONTACT A LOCATOR SERVICE PRIOR TO ANY EXCAVATION.

Installed by: Wayne Clontz

Operation Permit by: R.S. Date: 3 June 09

Existing System Inspected by: Date:

WHITE COPY Environmental Health YELLOW COPY (Final) Owner / Applicant PINK COPY (Initial) Owner / Applicant


198
100
1
200
202
CENTRAL DR
150
14
64
151
126
1
MEADOWLANE DR
105
2 BR House
Existing Septic Tank
70
8
69
13
50'
50'
50'
249
229
68'
89'
131
Keep out of Pump Line
Tank
70
130
BLK B
N
W
E
BLK A
NEWTON DR
265
1 inch = 50 feet