IREDELL COUNTY HEALTH DEPARTMENT

Statesville Phone TR 3-7271 Mooresville Phone NO 3-1271

PERMIT TO INSTALL SEPTIC TANK

Permit No. _____ Permit Date 12-31 1964

Owner SHERRILL LUMBR CO. Address _____

Installed By HOKE Address _____


Location of Property GREEN ACRES "INTO THEU R.6HT 2nd HOUSE ON LEFT

Tank		Capacity		Length of Lines		Fixtures	
Block	( )	1000	(X)	225'	(X)	No. of Baths	(1½
Precast	(X)	1250	( )	250'	( )	Dishwasher	( )
		1500	( )	Other _____		Garbage Grdr.	( )
		Other _____				Other _____	

NOTIFY HEALTH DEPARTMENT AT LEAST EIGHT HOURS BEFORE TANK IS TO BE INSPECTED.

Final Inspection 12-31 1964 Approved (✓) Disapproved ( )

Remarks _____

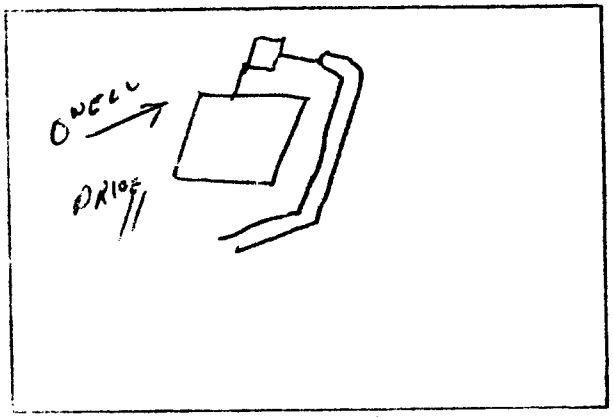

Sketch of Installation

Ralph G. Thomas RS

Sanitarian