IREDELL COUNTY HEALTH DEPARTMENT

STATESVILLE 704-878-5305 (or) MOORESVILLE 704-664-5281

IMPROVEMENT PERMIT / AUTHORIZATION TO CONSTRUCT / OPERATION PERMIT / EXISTING SYSTEM INSPECTION

PERMIT # 159503 PIN # 4724-75-1983 DATE 1-13-10

OWNER or APPLICANT Donna + Ray Havens PHONE: Business Home: 704 872-9090

OWNER or APPLICANT ADDRESS 513 Holly Street

LOCATION / DIRECTIONS Hwy 64/90 South From 40, (R) on Bristol, (L) on Greencrest, (R) on Holly Street 1st house on (L)

SUBDIVISION Greencrest BLOCK / SECTION LOT # 17 LOT AREA DESIGN FLOW Ex L.T.A.R. Ex

Septic Tank 1000 Gallons: STB FM Date 10-27-05
Pump Tank Gallons: PT Date
Pump Make Model Serial #
Nitrification Field No Fields Ex No Lines Ex Linear Feet Ex
Trench Width Ex Max. Trench Bottom Depth Ex Gravel Depth Ex

☒ New System ☐ Repair ☐ Expansion System Type I (II) III IV V VI
System Description: Tank Replacement
Repair System Description:
Maintenance Agreement Required ☐ YES ☒ NO
☒ GRAVITY ☐ PRESSURE


☒ Residence No. Bedrooms 3
☐ Business No. Persons
☐ Other No. Employees
☐ Slab ☐ Crawl Space
☒ Basement w/plumbing ☐ Basement w/o plumbing

Water Supply
☒ Private
☐ Public
☐ Community


Comments / Conditions: Holly St.

Comments / Conditions

INITIAL SITE SKETCH

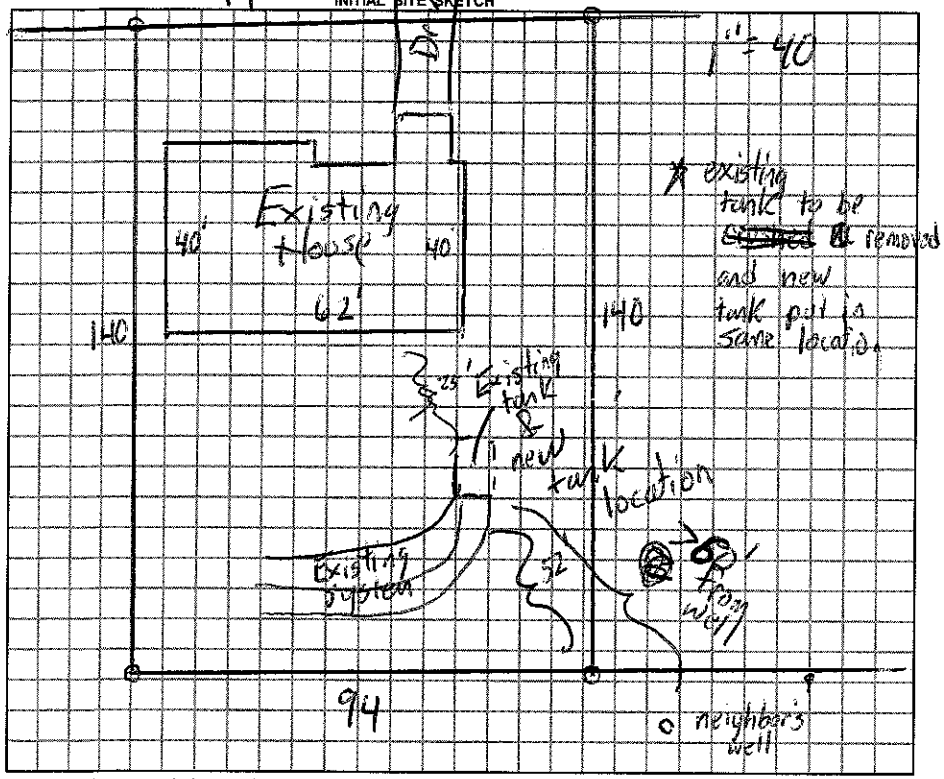

AS BUILT SKETCH

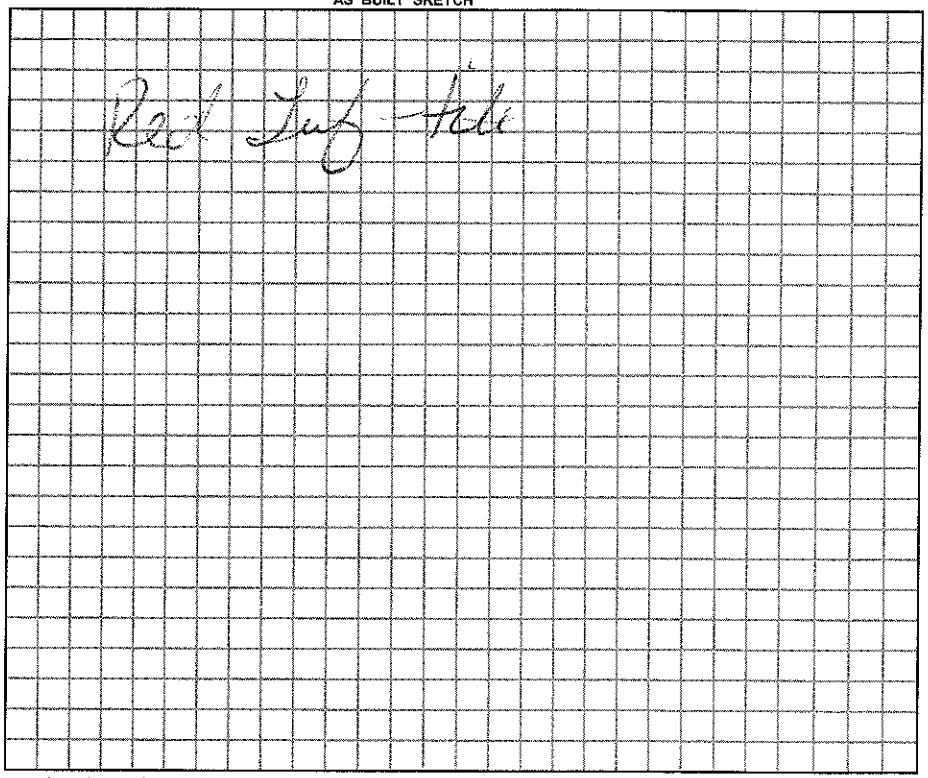

Permit can be suspended or revoked if any false information is supplied toward securing the permit / any unauthorized changes are made to the site / any unauthorized changes are made in the installation of the system.

☐ *IMPROVEMENT PERMIT w / plat valid without expiration.* ☒ *IMPROVEMENT PERMIT w / site plan valid for 60 mos.* ☒ *AUTHORIZATION TO CONSTRUCT valid for period equal to IMPROVEMENT PERMIT-not to exceed 60 mo.*

Owner / Applicant Signature: Ray R Havens Date 1-14-10

Improvement Permit by: James Date 1-13-10

Authorization to Construct by: James Date 1-13-10

YOU SHOULD CONTACT A LOCATOR SERVICE PRIOR TO ANY EXCAVATION.

Installed by: James Madden

Operation Permit by: Kelly Cox Date: 1-30-10

Existing System Inspected by: Date:

WHITE COPY Environmental Health YELLOW COPY (Final) Owner / Applicant PINK COPY (Initial) Owner / Applicant