IREDELL COUNTY HEALTH DEPARTMENT

STATESVILLE 704-878-5305 MOORESVILLE 704-664-5281

IMPROVEMENT PERMIT / AUTHORIZATION TO CONSTRUCT / OPERATION PERMIT / EXISTING SYSTEM INSPECTION

PERMIT# 1260592 PIN# 4724-75-3845 DATE 3-10-05

OWNER OR CONTRACTOR DENNIS DEAL PHONE: Business 704 902-3978 Home 704-876-0970

ADDRESS 576 SNOW CREEK ROAD, STATESVILLE NC 28625

LOCATION US 70 WEST, TR CENTRAL DRIVE, 0.5 MILE ON LEFT

SUBDIVISION GREENCREST BLOCK / SECTION LOT 23 & 24 LOT AREA 141' X 140' SITE CLASS. PS DESIGN FLOW 360 L.T.A.R. 0.25 GPD/FT²

Septic Tank: 1000 Gallons; STB 1007 Date 5-26-05
Pump Tank: 1000 Gallons; PT 27 Date 7-5-05
Pump Make: Goulds Model WE0311M Serial No G056207 1
Nitrification Field: No Fields 1 Square Feet EQ TO 1440 Linear Feet 360
No Lines THREE Trench Width 36" Max Trench Bottom Depth 36"

☑ New System ☐ Repair System Type: I, II, III, IV, V, VI
System Description: 25% REDUCTION, PUMP
Repair System Description: 50% REDUCTION, LOW PRESSURE
Maintenance Agreement Required: ☐ Yes ☑ No ☐ Other

☑ House/Mod. Home No. Bedrooms 3
☐ Mobile Home No. Bathrooms
☐ Business No. Employees


Water Supply: ☑ Individual ☐ Public ☐ Community WELL

☐ Slab ☑ Crawl Space ☐ Basement w/plumbing ☐ Basement wo/plumbing

Comments:/Conditions: ① INSTALL 25% REDUCTION SYSTEM ON CONTOUR AS SHOWN ② KEEP SYSTEM MAXIMUM FEASIBLE DISTANCE (~85') FROM WELL ③ SEE ATTACHED SHEETS FOR PUMP & PRESSURE MANIFOLD REQUIREMENT

Comments:/Conditions: SEPTIC TANK WITH MARKER INSTALLED USING "ZABEL" FILTER

INITIAL SITE SKETCH

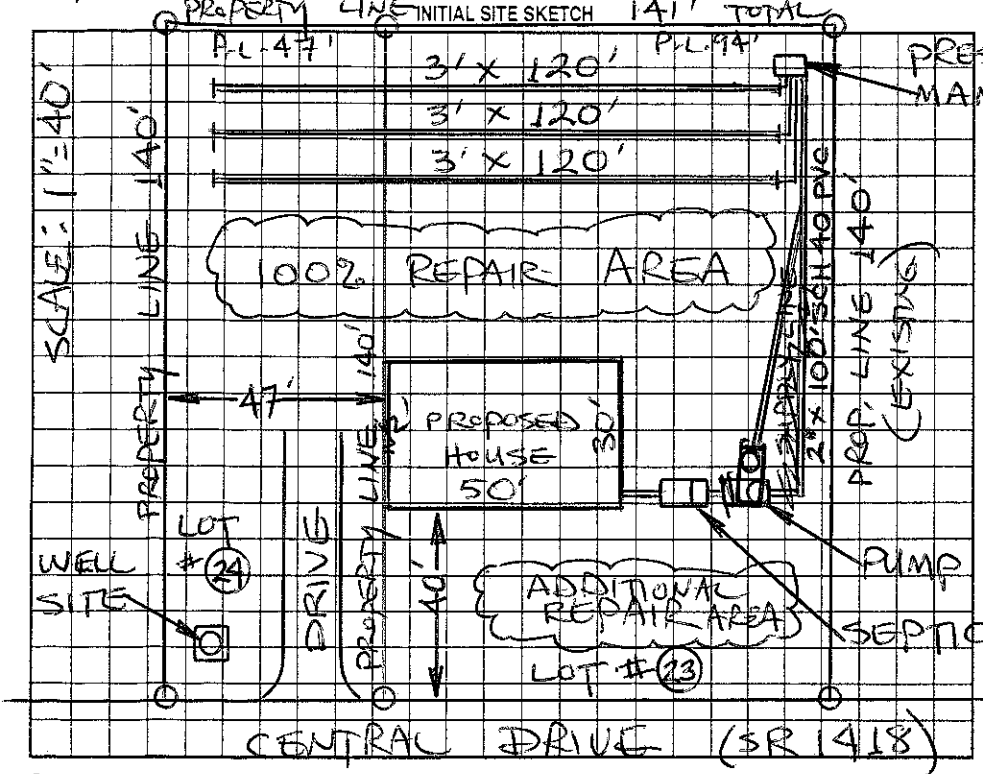

AS BUILT SKETCH

SYSTEM INSTALLED ACCORDING TO INITIAL SITE SKETCH

PUMP TANK

SEPTIC TANK

Permit can be suspended or revoked if any false information is supplied toward securing the permit/any unauthorized changes are made to the site/any unauthorized changes are made in the installation of the system. Improvement Permit with plat valid without expiration. Improvement Permit with site plan valid for sixty months. Authorization to Construct is valid for a period equal to that of Improvement Permit – not to exceed sixty months.

Signed: Dennis Deal date 5-11-5 Installed by: JAMES HUDLER

Improvement Permit by: STEVE HEDRICK date 3-10-05 Operation Permit by: STEVE HEDRICK date 2-20-06

Authorization to Construct by: STEVE HEDRICK date 5-10-05 Existing System Inspection by: _____ date _____

HEALTH DEPT. COPY: WHITE OWNER COPY (FINAL): YELLOW OWNER COPY (INITIAL): PINK