IREDELL COUNTY HEALTH DEPARTMENT

STATESVILLE 704-878-5305 (ev) MOORESVILLE 704-664-5281

IMPROVEMENT PERMIT / AUTHORIZATION TO CONSTRUCT / OPERATION PERMIT / EXISTING SYSTEM INSPECTION

PERMIT# 140523 PIN# 4724-75-3943 25 DATE 2-7-7

OWNER OR APPLICANT DENNIS M. DEAL PHONE: Business 704-902-3978 Home

ADDRESS 576 SNOW CREEK ROAD, STATESVILLE NC 28625-2146

LOCATION US 70 WEST, TR CENTRAL DRIVE, LOT ON LEFT 2ND BEFORE GREENCREST

SUBDIVISION GREENCREST BLOCK / SECTION LOT 22 LOT AREA 0.454 ACRE SITE CLASS. PS DESIGN FLOW 360 L.T.A.R. 0.30 GPD/FT²

Septic Tank: 1000 Gallons; STB 1007 Date 4-23-07

Pump Tank: Gallons; PT Date

Pump Make: Model Serial No.

Nitrification Field: No Fields 1 Square Feet 66 M 1200 Linear Feet 300

No Lines THREE Trench Width 36" Max Trench Bottom Depth 30

☑ New System ☐ Repair ☐ Expansion System Type: I II III IV V VI

System Description: 25% REDUCTION, GRAVITY

Repair System Description: 50% REDUCTION, GRAVITY

Maintenance Agreement Required: ☐ Yes ☑ No

Gravel Depth N/A ☑ Gravity ☐ Pressure

☑ House/Mod. Home No. Bedrooms 3

☐ Mobile Home No. Persons

☐ Business No. Employees

☐ Other

Water Supply: ~~Individual~~ ☐ Public ☐ Community WELL


☐ Slab ☑ Crawl Space ☐ Basement w/plumbing ☐ Basement wo/plumbing

Comments:/Conditions: INSTALL 25% REDUCTION SYSTEM ON CONTOUR AS SHOWN.

~SCALE: 1"=40'

Comments:/Conditions: SEPTIC TANK WITH MARKER INSTALLED USING "BOWCO" FILTER.

INITIAL SITE SKETCH

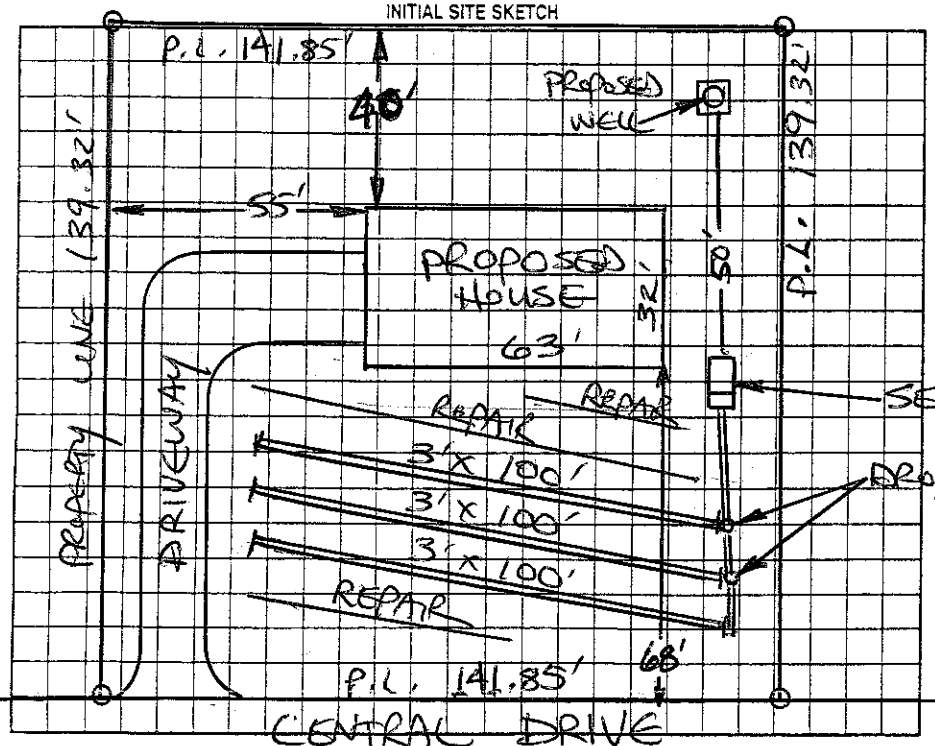

AS BUILT SKETCH

SYSTEM INSTALLED ACCORDING TO INITIAL SITE SKETCH

Permit can be suspended or revoked if any false information is supplied toward securing the permit/any unauthorized changes are made to the site/any unauthorized changes are made in the installation of the system. Improvement Permit with plat valid without expiration ☐ Improvement Permit with site plan valid for sixty months ☑ Authorization to Construct is valid for a period equal to that of Improvement Permit – not to exceed sixty months.

Signed: Ramon Deal date 2-7-7

Improvement Permit by: STEVE HEDRICK date 2-7-07

Authorization to Construct by: STEVE HEDRICK date 2-7-07

Installed by: JAMES HUSLER

Operation Permit by: STEVE HEDRICK date 7-3-07

Existing System Inspection by: date

HEALTH DEPT. COPY: WHITE OWNER COPY (FINAL): YELLOW OWNER COPY (INITIAL): PINK