IREDELL COUNTY HEALTH DEPARTMENT

STATESVILLE 704-878-5305 MOORESVILLE 704-664-5281

IMPROVEMENT PERMIT / AUTHORIZATION TO CONSTRUCT / OPERATION PERMIT / EXISTING SYSTEM INSPECTION

PERMIT# REPAIR PIN# 4724-75-5012 DATE 8-16-06

OWNER OR APPLICANT ALEEN M. ALEXANDER PHONE: Business Home 704-878-2268

ADDRESS 631 CENTRAL DR, STATESVILLE, NC 28677

LOCATION US 70 WEST, TR CENTRAL DRIVE, HOUSE ON RIGHT AT BOX #631

SUBDIVISION BLOCK / SECTION LOT LOT AREA 1.32 ACRE SITE CLASS PS DESIGN FLOW 360 L.T.A.R. 0.30 GPD/FT2

Septic Tank: EXISTING Gallons: STB Date

Pump Tank: Gallons; PT Date

Pump Make: Model Serial No.

Nitrification Field: No Fields 1 Square Feet 1200 Linear Feet 400

No Lines FIVE Trench Width 36" Max Trench Bottom Depth (23") Gravel Depth 12"

☑ New System ☐ Repair ☐ Expansion System Type: I (II) III IV V VI

System Description: CONVENTIONAL, GRAVITY

Repair System Description: CONVENTIONAL, GRAVITY

Maintenance Agreement Required: ☐ Yes ☑ No

☑ Gravity ☐ Pressure ☐ Slab ☑ Crawl Space ☐ Basement w/plumbing ☐ Basement wo/plumbing

☑ House/Mod. Home No. Bedrooms 3

☐ Mobile Home No. Persons

☐ Business No. Employees


☐ Other

Water Supply: ☑ Individual ☐ Public ☐ Community WELL


Comments/Conditions: ① AN "ACCEPTED" SYSTEM MAY ALSO BE USED. ② INSTALL LINES ON CONTOUR NO DEEPER THAN 23" ③ SYSTEM TO BE REPAIRED BY 9-18-06.

Comments/Conditions: Installed AS Quick-4 (Infiltrator)

INITIAL SITE SKETCH

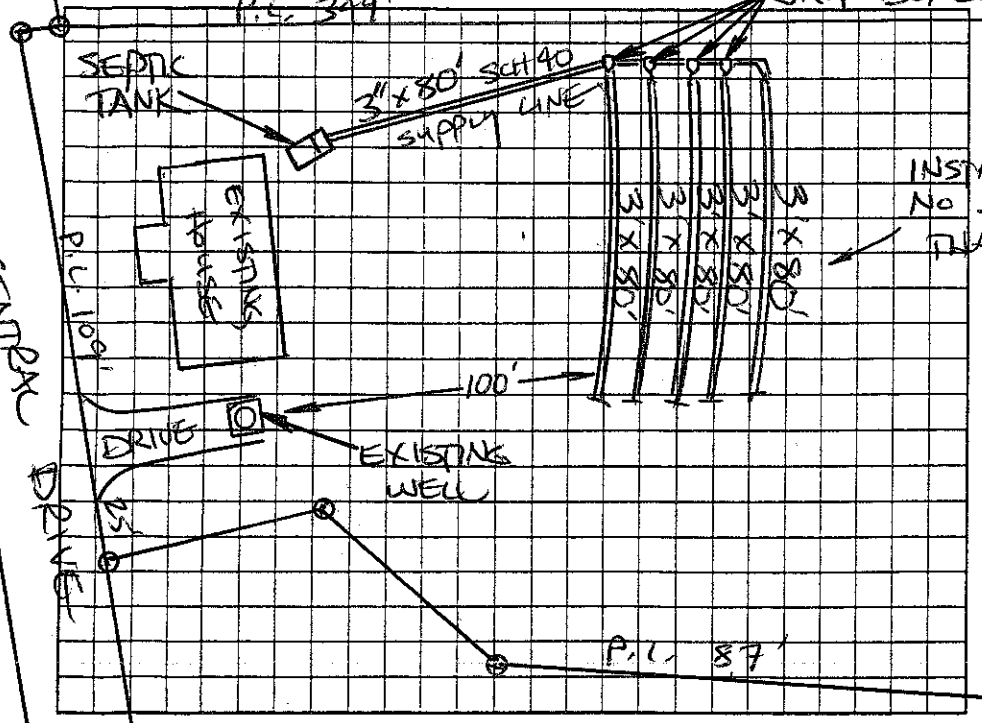

AS BUILT SKETCH

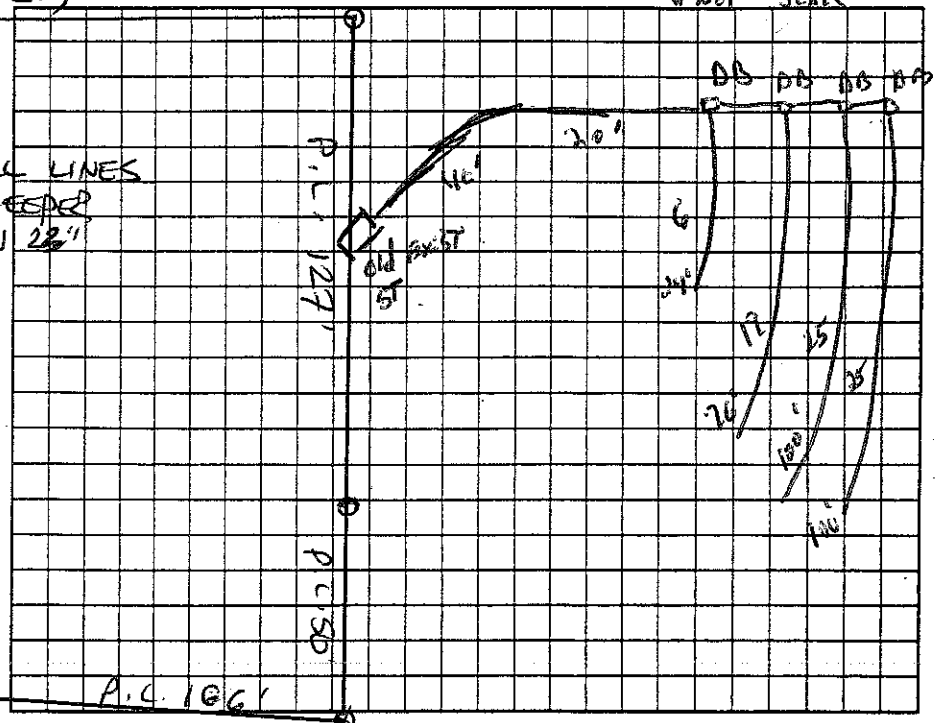

Permit can be suspended or revoked if any false information is supplied toward securing the permit/any unauthorized changes are made to the site/any unauthorized changes are made in the installation of the system. Improvement Permit with plat valid without expiration ☐ Improvement Permit with site plan valid for sixty months ☑ Authorization to Construct is valid for a period equal to that of Improvement Permit – not to exceed sixty months.

Signed: Aleen M. Alexander date

Installed by: Marty Tucker

Improvement Permit by: STEVE HEDRICK date 8-16-06

Operation Permit by: R.S. date 28 September 06

Authorization to Construct by: STEVE HEDRICK date 8-16-06

Existing System Inspection by: date

HEALTH DEPT. COPY: WHITE OWNER COPY (FINAL): YELLOW OWNER COPY (INITIAL): PINK