IREDELL COUNTY HEALTH DEPARTMENT

Statesville Phone TR 3-7271 Mooresville Phone NO 3-1271

PERMIT TO INSTALL SEPTIC TANK

Permit NO. _____ Permit Date 3-15 1966

Owner Sherrill Lumber Co. Address Statesville, N

Installed By Clyde Lobe Address Statesville, N.C.


Location of Property Hwy 90 W & Brutal Rd. & Green Crest Sub Div. Last St Rt. 1st Lane Left.

Tank		Capacity		Length of Lines		Fixtures	
Block	( )	1000	(✓)	225'	(✓)	No. of Baths	( )
Precast	( )	1250	( )	250'	( )	Dishwasher	( )
		1500	( )	Other _____		Garbage Grdr.	( )
		Other _____				Other _____	

NOTIFY HEALTH DEPARTMENT AT LEAST EIGHT HOURS BEFORE TANK IS TO BE INSPECTED.

Final Inspection 3-15 1966 Approved (✓) Disapproved ( )

Remarks Very Steep -

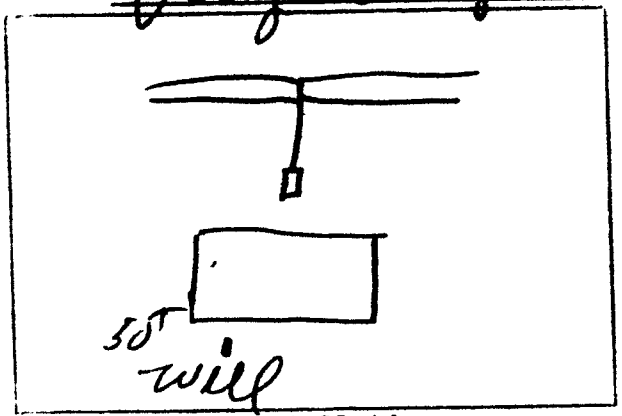

Sketch of Installation

#1

Andrew J. Hutchinson R.S.

Sanitarian