IREDELL COUNTY HEALTH DEPARTMENT

THIS PERMIT VOIDS PREVIOUS ISSUED 12-6-96

STATESVILLE 704-878-5305 MOORESVILLE 704-664-5281

IMPROVEMENT PERMIT / AUTHORIZATION TO CONSTRUCT / OPERATION PERMIT / EXISTING SYSTEM INSPECTION

PERMIT# 77599 PIN# DATE 12-8-98

OWNER OR CONTRACTOR ELIZABETH MARTINEZ PHONE: Business 873-1481 Home

ADDRESS 2510 PACER LANE STATESVILLE NC 28677

LOCATION BRISTOL DRIVE TO GREENCREST, TL CENTRAL DR, TL ~~BRISTOL~~ PACER LANE, 3RD LOT ON RIGHT

SUBDIVISION SHERRILL EST. BLOCK / SECTION II LOT 6 LOT AREA 20,491 SF SITE CLASS PS DESIGN FLOW 360 L.T.A.R 0.30 GPD/FT²

Septic Tank: 1000 Gallons; STB 1012 Date 10-12-98
Pump Tank: 1000 Gallons; PT 17 Date 8-12-98
Pump Make: Model Serial No
Nitrification Field: No Fields 1 Square Feet 60 to 1200 Linear Feet 200
No Lines FOUR Trench Width 24" Max Trench Bottom Depth 36" Gravel Depth SAND 6"

✓ New System Repair System Type I II III IV V
System Description: PPBPS, PUMP-FED
Repair System Description: PPBPS, LOW PRESSURE
Maintenance Agreement Required Yes LW


House/Mod. Home No. Bedrooms 3
Mobile Home No. Bathrooms 2
Business No. Employees
Other
Slab Crawl Space Basement w/plumbing Basement w/o plumbing

Water Supply: ✓ Individual Public (-) Community WELL

Comments/Conditions: ① INSTALL FORTY-FOUR PPBPS PANELS IN FOUR EQUAL LENGTH LINES ON CONTOUR AS SHOWN ② SCOUR TRENCH SIDEWALLS AND APPLY A LIGHT DUSTING OF LIME PRIOR TO INSTALLING PANELS.

Comments/Conditions:

INITIAL SITE SKETCH SCALE: 1" = 30'

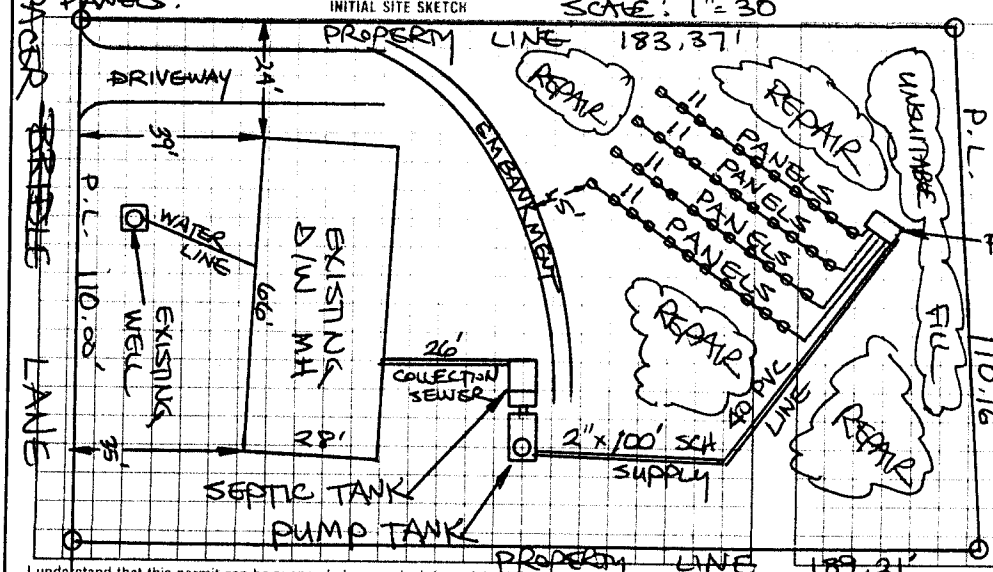

AS BUILT SKETCH

SYSTEM INSTALLED ACCORDING TO INITAL SITE SKETCH

I understand that this permit can be suspended or revoked if any false information is supplied toward securing the permit, any unauthorized changes are made to the site/any unauthorized changes are made in the installation of the system. Improvement Permit with plat valid without expiration. Improvement Permit with site plan valid for sixty months. Authorization to Construct is valid for a period equal to that of Improvement Permit – not to exceed sixty months.

Signed: [signature] date 12.8.98 Installed by: DONALD LACKEY

Improvement Permit by: STEVE HEDRICK date 12-8-98 Operation Permit by: STEVE HEDRICK date 1-4-98

Authorization to Construct by: STEVE HEDRICK date 12-8-98 Existing System Inspection by: date

HEALTH DEPT. COPY: WHITE INSPECTION COPY (FINAL): GREEN OWNER COPY (FINAL): YELLOW INSPECTION COPY (INITIAL): PINK OWNER COPY (INITIAL): GOLD