IREDELL COUNTY HEALTH DEPARTMENT

Statesville Phone TR 3-7271 Mooresville Phone NO 3-1271

PERMIT TO INSTALL SEPTIC TANK

Permit NO._____ Permit Date 3-23 1964

Owner SHEAR III LAKE CO. Address STI

Installed By BALLARD Address STONY POINT, N.C.

Location of Property ONT #90 WEST LEFT AT KENNADE


TO GREEN CREST LAST HOUSE ON LEFT BEFORE CURVE.

Tank		Capacity		Length of Lines		Fixtures	
Block	( )	800	( )	150'	( )	No. of Baths	(1½)
Precast	(✓)	900	( )	175'	( )	Dishwasher	( )
		1000	(✓)	200'	( )	Garbage Grdr.	( )
		1100	( )	225'	(✓)	Auto-Washer	( )
		1200	( )	250'	( )	Other_____	
		Other_____		Other_____			

NOTIFY HEALTH DEPARTMENT AT LEAST EIGHT HOURS BEFORE TANK IS TO BE INSPECTED.

Final Inspection 3-23 1964 Approved (✓) Disapproved ( )

Remarks_____

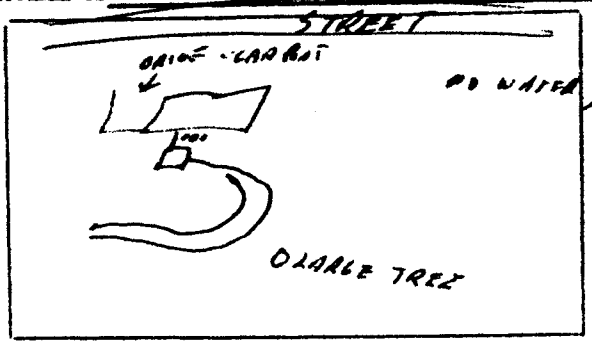

Sketch of Installation

Ralph G. Thorn, R.S.

Sanitarian