IREDELL COUNTY HEALTH DEPARTMENT

Statesville Phone TR 3-7271 Mooresville Phone NO 3-1271

PERMIT TO INSTALL SEPTIC TANK

Permit NO. _____ Permit Date 2-17 1964

Owner SHERRILL LMBR CO Address 3TO.

Installed By BALLARD PLB. CO Address STONY POINT


Location of Property GREEN CREST LAST HOUSE ON LEFT BEFORE CURVE

Tank		Capacity		Length of Lines		Fixtures	
Block	( )	800	( )	150'	( )	No. of Baths	(1½)
Precast	(✓)	900	( )	175'	( )	Dishwasher	( )
		1000	(✓)	200'	( )	Garbage Grdr.	( )
		1100	( )	225'	(✓)	Auto-Washer	( )
		1200	( )	250'	( )	Other _____	
		Other _____		Other _____			

NOTIFY HEALTH DEPARTMENT AT LEAST EIGHT HOURS BEFORE TANK IS TO BE INSPECTED.

Final Inspection 2-17 1964 Approved (✓) ~~Disapproved~~ ( )

Remarks _____

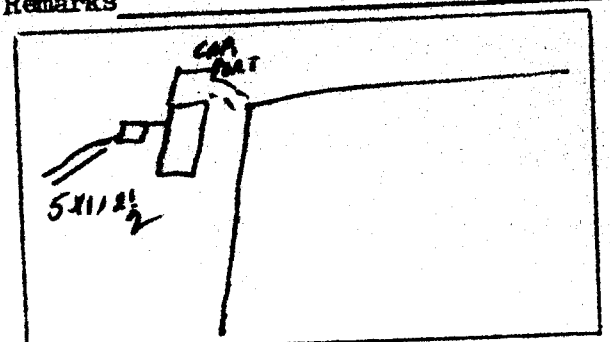

Sketch of Installation

Raymond G Johnson Jr.

Sanitarian