77695

IREDELL COUNTY HEALTH DEPARTMENT

STATESVILLE 704-878-5305 MOORESVILLE 704-664-5281

IMPROVEMENT PERMIT / CERTIFICATE OF COMPLETION / OPERATION PERMIT / EXISTING SYSTEM INSPECTION

PROPERTY DESCRIPTION NO. STATESVILLE DATE 12-6-96 TAX MAP NO. 6K-9-A-51,52,55,55A / 6K-10-A-10,11 Watershed: ☐ Yes ☑ No

OWNER OR CONTRACTOR DONNIE WALKER PHONE: Business 873-1481 Home

ADDRESS 249 PRESSLY FARM ROAD, STONY POINT, NC 28678

LOCATION BRISTOL DRIVE, TL GREENCREST, TL CENTRAL DRIVE, TL BRIDLE LANE, 1ST LOT ON LEFT

SUBDIVISION SHERRILL ESTATES BLOCK / SECTION II LOT 14 LOT AREA 190'X122'X195'X100' SITE CLASS. PS DESIGN FLOW 360 L.T.A.R. 0.30 GPD/FT²

Septic Tank: 1000 Gallons; STB 794 Date 8-5-98
Pump Tank: _____ Gallons; PT _____ Date _____
Pump Make: _____ Model _____ Serial No. _____
Nitrification Field: No Fields 1 Square Feet Eq. to 1200 Linear Feet 300+
No Lines FIVE Trench Width 36" Max Trench Bottom Depth 36"

☑ New System ☐ Repair System Type: I, II, III, IV, V, VI
System Description: CHAMBERED GRAVITY
Repair System Description: PPBPS GRAVITY
Maintenance Agreement Required: ☐ Yes ☑ No
Gravel Depth N/A

☐ House/Mod. Home ☑ Mobile Home ☐ Business ☐ Other
No. Bedrooms 3 No. Bathrooms 2 No. Employees ____


☐ Slab ☑ Crawl Space ☐ Basement w/plumbing ☐ Basement wo/plumbing

Water Supply: ☑ Individual ☐ Community ☐ Public WELL

Comments: ① KEEP SYSTEM MAXIMUM FEASIBLE DISTANCE (85') FROM WELL ② INSTALL 50 CHAMBERS IN FIVE EQUAL LENGTH LINES ON CONTOUR.

Comments:

INITIAL SITE SKETCH SCALE: 1"=40'

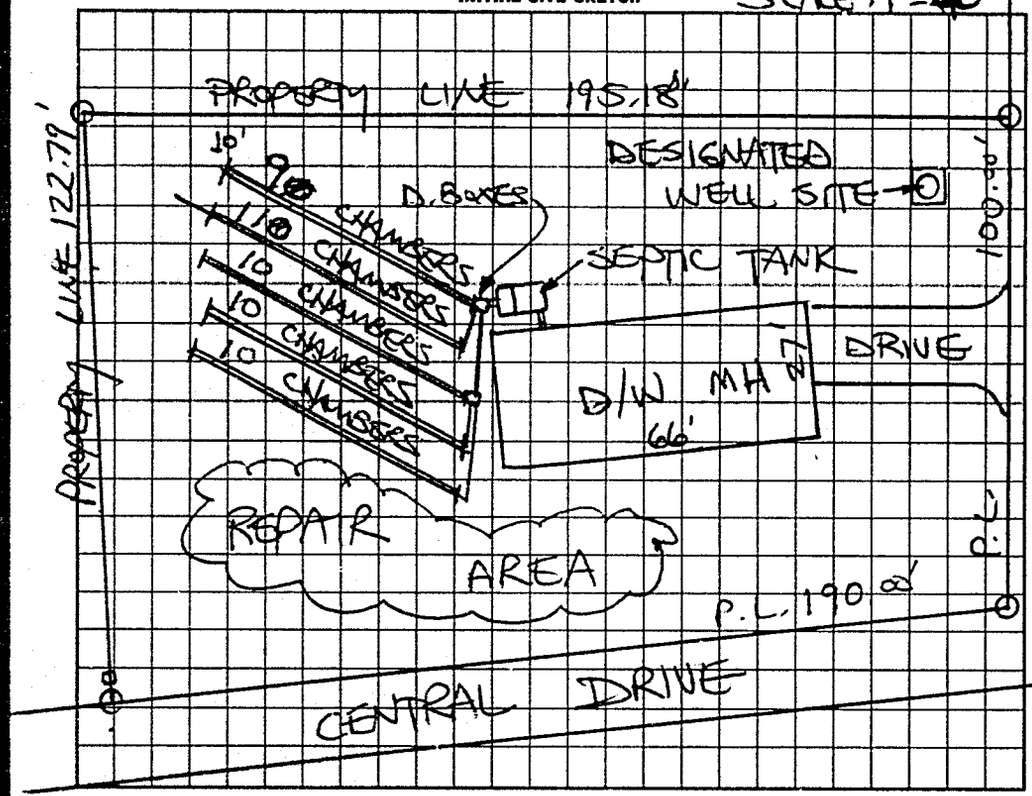

AS BUILT SKETCH

SYSTEM INSTALLED ACCORDING TO INITAL SITE SKETCH

I understand that this permit can be suspended or revoked if any false information is supplied toward securing the permit/any unauthorized changes are made to the site/any unauthorized changes are made in the installation of the system.
Auth. to Const. is valid for a period equal to the validity of the IP not to exceed five years. IP w/site plan is valid five years.

Signed: E. W. Hall

Improvement Permit by: STEVE HEDRICK date 12-6-96
Authorization to Construct
XXXXXXXXXXXXXXXXXXXX by: STEVE HEDRICK date 12-6-96

Installed by: RICK SHOOK
Certificate of Completion by: STEVE HEDRICK date 11-2-98
Operation Permit by: _____ date _____

HEALTH DEPT. COPY: WHITE INSPECTION COPY (FINAL): GREEN OWNER COPY (FINAL): YELLOW INSPECTION COPY (INITIAL): PINK OWNER COPY (INITIAL): GOLD

699000