IREDELL COUNTY HEALTH DEPARTMENT

STATESVILLE 704-878-5305 MOORESVILLE 704-664-5281

IMPROVEMENT PERMIT / CERTIFICATE OF COMPLETION / OPERATION PERMIT / EXISTING SYSTEM INSPECTION

PROPERTY DESCRIPTION NO. REPAIR DATE 7/15/93 TAX MAP NO. REPAIR

OWNER OR CONTRACTOR DALLAS SAFRIET PHONE: Business Home 873-8670

ADDRESS 2102 E. BROAD ST. STATESVILLE, NC

LOCATION #2409 SECOND ST.

SUBDIVISION BLOCK / SECTION LOT 2409 LOT AREA LIMITED SITE CLASS. PS L.T.A.R.

Water Supply: ☐ Individual ☐ Community ☑ Public

Septic Tank: EXISTING Gallons: STB Date

Pump Tank: Gallons: PT Date

Nitrification Field: No Fields 2 Square Feet 345 Linear Feet 115'

No Lines 2 Trench Width 36" Trench Depth Gravel Depth 18"

☐ New System ☑ Repair System Type: I. II. III. IV. V. VI

System Description:

Repair System Description: CONV. GRAVITY

Maintenance Agreement Required: ☐ Yes ☑ No

☑ House/Mod. Home No. Bedrooms

☐ Mobile Home No. Bathrooms EXISTING

☐ Business No. Employees

☐ Other

Garbage Disposal: ☐ Yes ☑ No

Auto. Dishwasher: ☐ Yes ☐ No

Auto. Washing Machine: ☑ Yes ☐ No


Other

☐ Slab ☑ Crawl Space ☐ Basement w/plumbing ☐ Basement wo/plumbing

Comments: (1) SYSTEM CHANGED FROM 150 LINEAR FEET TO 115' FOR EASE OF INSTALLATION (2) SYSTEM LINES ARE DEEP DUG TO INITIAL TANK DEPTH AND LOCATION OF EXISTING BED

INITIAL SITE SKETCH

AS BUILT SKETCH

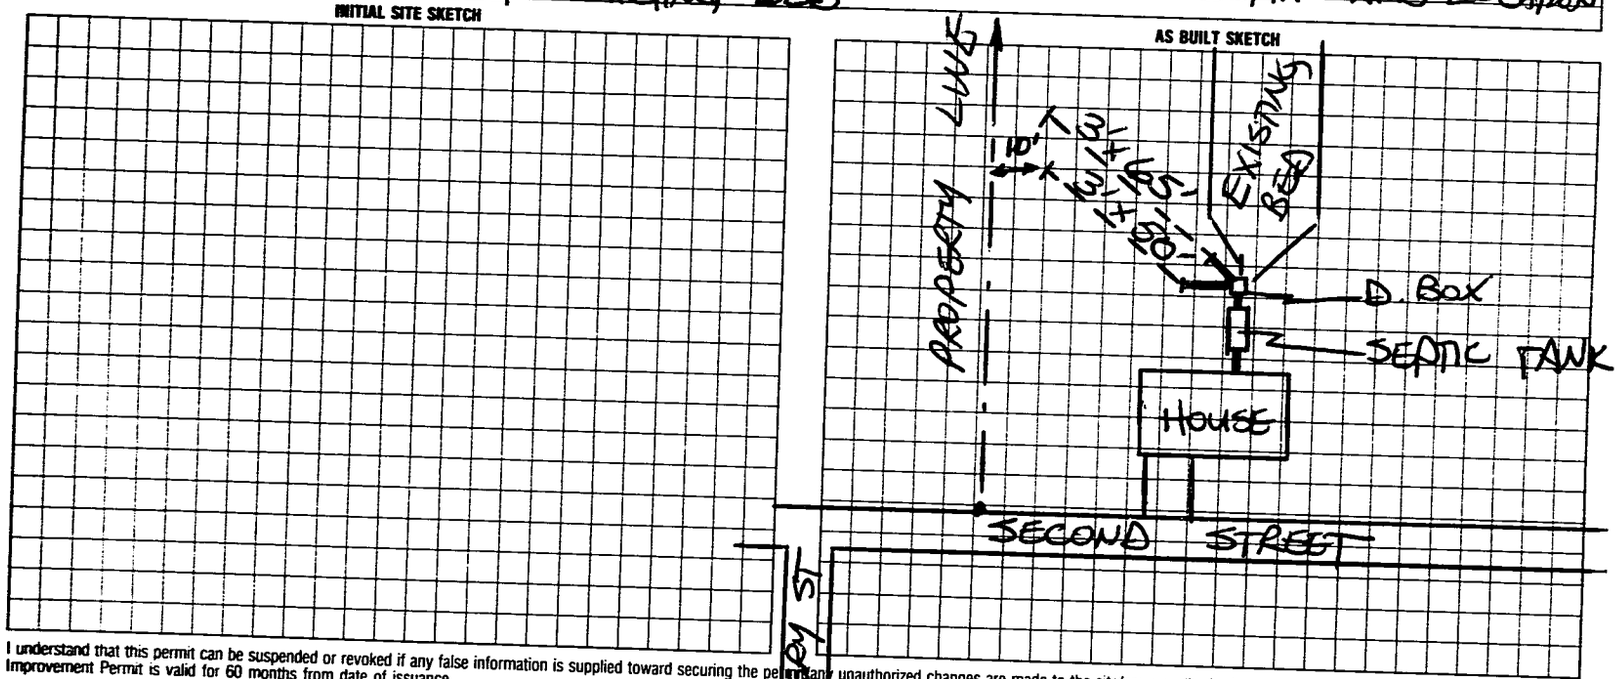

I understand that this permit can be suspended or revoked if any false information is supplied toward securing the permit or if any unauthorized changes are made to the site/any unauthorized changes are made in the installation of the system. Improvement Permit is valid for 60 months from date of issuance.

Signed:

Improvement Permit by: STEVE HEDRICK date 11/9/92

Existing System Inspection by: date

Installed by: AAA ENTERPRISE

Certificate of Completion by: STEVE HEDRICK date 7/15/93

Operation Permit by: date

HEALTH DEPT. COPY: WHITE INSPECTION COPY (FINAL): GREEN OWNER COPY (FINAL): YELLOW INSPECTION COPY (INITIAL): PINK OWNER COPY (INITIAL): GOLD