IREDELL COUNTY HEALTH DEPARTMENT

STATESVILLE 704-878-5305 MOORESVILLE 704-664-5281

IMPROVEMENT PERMIT / AUTHORIZATION TO CONSTRUCT / OPERATION PERMIT / EXISTING SYSTEM INSPECTION

PERMIT# _____ PIN# _____

OWNER OR CONTRACTOR Billy Poole PHONE: Business _____ Home 876 4992

ADDRESS 250 9 1st Street Statesville DATE 1-27-99

LOCATION Front St Turn on Bakery Dr. Turn Rt 1st St on left.

SUBDIVISION _____ BLOCK / SECTION _____ LOT _____ LOT AREA _____ SITE CLASS _____ DESIGN FLOW _____ L.T.A.R. _____

Septic Tank: EX Gallons; STB _____ Date _____

Pump Tank: _____ Gallons; PT _____ Date _____

Pump Make: _____ Model _____ Serial No. _____

Nitrification Field: No Fields 1 Square Feet 600 Linear Feet 200

No Lines 2 Trench Width 72" Max Trench Bottom Depth 36" Gravel Depth 12"

☐ New System ☑ Repair System Type: I II III IV V VI

System Description: _____

Repair System Description: Conv. Gravity

Maintenance Agreement Required: ☐ Yes ☑ No

☐ House/Mod. Home No. Bedrooms 2

☐ Mobile Home No. Bathrooms 1

☐ Business No. Employees _____

☐ Other _____


☐ Slab ☐ Crawl Space ☐ Basement w/plumbing ☐ Basement wo/plumbing

Water Supply: ☐ Individual ☑ Public ☐ Community


Comments/Conditions: Tie washer back on S.T. System

Comments/Conditions _____

INITIAL SITE SKETCH

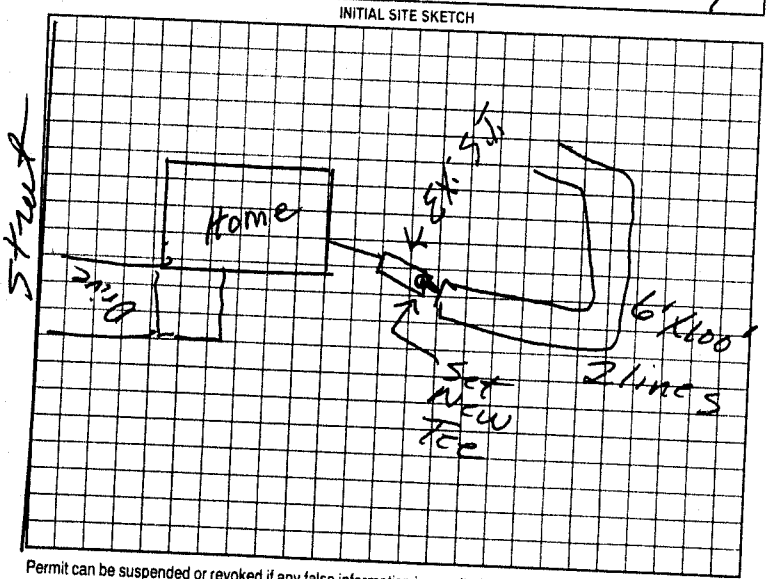

AS BUILT SKETCH

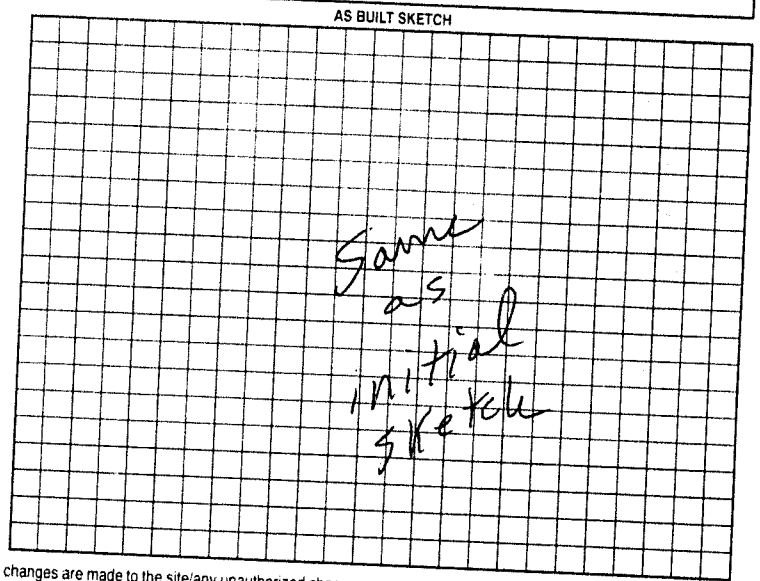

Permit can be suspended or revoked if any false information is supplied toward securing the permit/any unauthorized changes are made to the site/any unauthorized changes are made in the installation of the system. Improvement Permit with plat valid without expiration. Improvement Permit with site plan valid for sixty months. Authorization to Construct is valid for a period equal to that of Improvement Permit – not to exceed sixty months.

Signed: X Bobbie B. Poole date _____

Improvement Permit by: R.C. Moore date 1-27-99

Authorization to Construct by: R.C. Moore date 1-27-99

Installed by: James Hutler

Operation Permit by: R.C. Moore date 6-17-99

Existing System Inspection by: _____ date _____

HEALTH DEPT. COPY. WHITE OWNER COPY (FINAL) YELLOW OWNER COPY (INITIAL) PINK